

97 DEC 22 AM 9:55

LIBER 325 PAGE 134

LAND CORNER RECORDATION CERTIFICATE
Filing Requirement of Act 74, Mich. P.A. 1970

Janet M. Lamb
REGISTER OF DEEDS

For corners in

Presque Isle (County)	Located In:	Corner Code #
1. Public Land Survey	T <u>34N</u> R <u>5E</u>	<u>K-8</u>
	T <u> </u> R <u> </u>	<u> </u>
	T <u> </u> R <u> </u>	<u> </u>
	T <u> </u> R <u> </u>	<u> </u>
2. Property Controlling in Section	S <u> </u> T <u> </u> R <u> </u>	<u> </u>
	S <u> </u> T <u> </u> R <u> </u>	<u> </u>
3. Miscellaneous Property in Sec.	S <u> </u> T <u> </u> R <u> </u>	<u> </u>
	S <u> </u> T <u> </u> R <u> </u>	<u> </u>

Register of Deeds Stamp & File Number

4. Lot No. _____, Recorded Plat _____
5. Private Claims _____

I, Ronald Bischer, in a field survey on Sept 10 19 97 do hereby state that under requirements of P.A. 74, Michigan P.A. of 1970, the corner points mentioned in lines 1 and 2 above were in conformance with regulations and rules therefore as required in the current manual of survey instructions of the United States Department of the Interior, Bureau of Land Management or by a decree of a Court of Law and/or that the corner points mentioned in lines 3, 4 and 5 above were in conformance with the rules of the Michigan Board of Land Surveyors or by a Decree of a Court of Law; established, re-established, monumented, recovered, found as expressed below:

NOTE: Not more than 2 corners, all in the same town and range, may be recorded on this certificate.

	A	B	C	D	E	F	G	H	I	J	K	L	M
1													
2	6		5		4		3		2		1		
3													
4	7		8		9		10		11		12		
5													
6	10		17		16		15		14		13		
7													
8	19		20		21		22		23		24		
9													
10	30		29		28		27		26		25		
11													
12	31		32		33		34		35		36		
13													

A. Description of original monument and accessories and/or subsequent restoration:


K-8
GLO Notes
Alfred Millerd
Set Post
Beech 12" N16° E 31 lks
Beech 10" S22° W 8 lks
1961 James Scott #8318 set 1" pipe and three witnesses
1978 Delmar Porter #15410
Set 1/2" rod and cap in Mon box from Scotts witnesses set two new witnesses

B. Description of corner evidence found and/or method applied in restoring or reestablishing corner:

K-8
Found 1/2" Rod and Cap #22428 in Mon. Box
one Scott witness
two Porter witnesses

SURVEY & REMONUMENTATION

JAN 14 1998

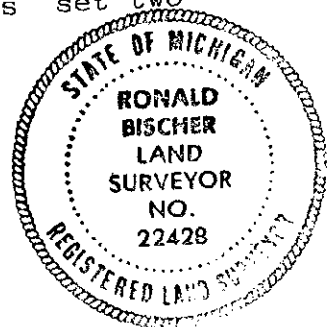

SECTION

C. Description of monument for corner and accessories established to perpetuate locating the position of the corner:

K-8
1/2" Rod and Cap #22428 in Mon. Box
West 40.00' 1/2" Rod and Cap #21559 Scott Witness
N88° W 46.88' Power Pole Porter witness
N88° W 44.32' Fence corner Porter witness
N40° W 62.25' Fence post Porter witness

Ratified by Peer Group in accordance with P.A. 345

Chairman *Norman J. Quinn*
Date 10/30/97

Signed by Ronald R. Bischer
Surveyor's Michigan License No. 22428

Date Oct. 8, 1997