

1997 PRESQUE ISLE COUNTY, STATE OF MICHIGAN REMONUMENTATION PRESQUE ISLE COUNTY RECORDED

LAND CORNER RECORDATION CERTIFICATE Filing Requirement of Act 74, Mich. P.A. 1970

97 DEC 22 AM 9:55

For corners in

Presque Isle (County)	Located in:	Corner Code #
1. Public Land Survey	T <u>34</u> N R <u>5E</u>	<u>K-9</u>
	T _____ R _____	_____
	T _____ R _____	_____
	T _____ R _____	_____
2. Property Controlling in Section	S _____ T _____ R _____	_____
	S _____ T _____ R _____	_____
3. Miscellaneous Property in Sec.	S _____ T _____ R _____	_____
	S _____ T _____ R _____	_____

Janet M. Lamb REGISTER OF DEEDS

Register of Deeds Stamp & File Number

4. Lot No. _____, Recorded Plat _____
5. Private Claims _____

I, Ronald Bischer, in a field survey on Sept 10 19 97 do hereby state that under requirements of P.A. 74, Michigan P.A. of 1970, the corner points mentioned in lines 1 and 2 above were in conformance with regulations and rules therefore as required in the current manual of survey instructions of the United States Department of the Interior, Bureau of Land Management or by a decree of a Court of Law and /or that the corner points mentioned in lines 3, 4 and 5 above were in conformance with the rules of the Michigan Board of Land Surveyors or by a Decree of a Court of Law; established, re-established, monumented, recovered, found as expressed below:

NOTE: Not more than 2 corners, all in the same town and range, may be recorded on this certificate.

	A	B	C	D	E	F	G	H	I	J	K	L	M
1													
2		6		5		4		3		2		1	
3													
4		7		8		9		10		11		12	
5													
6		18		17		16		15		14		13	
7													
8		19		20		21		22		23		24	
9													
10		30		29		28		27		26		25	
11													
12		31		32		33		34		35		36	
13													

A. Description of original monument and accessories and/or subsequent restoration:

K-9

GLO Notes
Alfred Millerd
Set Post
Beech 12" S68° E 48 lks
Hemlock 12" N35° W 9 lks

1979 Delmar Porter #15410
Found 2" pipe set 1/2" rod & cap
and three witnesses

1993 James Beck #21559 found 1/2" rod
and cap #15410 Set one new witness

B. Description of corner evidence found and/or method applied in restoring or reestablishing corner:


K-9

Found 1/2" Rod and Cap #21559
and Beck witness
and two Porter Witnesses

SURVEY & REMONUMENTATION

JAN 14 1998

SECTION

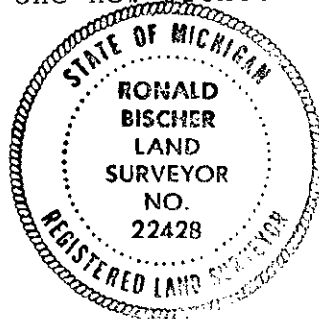

C. Description of monument for corner and accessories established to perpetuate locating the position of the corner:

K-9

1/2" Rod and cap #21559
N52° E 51.88' 6" Apple Beck Witness
S49° E 50.95' 16" Spruce Porter Witness
S48° W 71.55' Power Pole Porter Witness
S66° W 69.48' Tele. Cable box

Ratified by Peer Group
in accordance with P.A. 345
Chairman Abraham J. ...
Date 12/30/97

Signed by Ronald R. Bischer
Surveyor's Michigan License No. 22428

Date Oct. 8, 1997