

1997 PRESQUE ISLE COUNTY, STATE OF MICHIGAN REMONUMENTATION

LAND CORNER RECORDATION CERTIFICATE 7 DEC 22 AM 9:55  
Filing Requirement of Act 74, Mich. P.A. 1970

For corners in

|                                    |                   |               |
|------------------------------------|-------------------|---------------|
| <u>Presque Isle</u><br>(County)    | Located In:       | Corner Code # |
| 1. Public Land Survey              | T34NR 5E          | K-10          |
|                                    | T ___ R ___       | _____         |
|                                    | T ___ R ___       | _____         |
|                                    | T ___ R ___       | _____         |
| 2. Property Controlling in Section | S ___ T ___ R ___ | _____         |
|                                    | S ___ T ___ R ___ | _____         |
| 3. Miscellaneous Property in Sec.  | S ___ T ___ R ___ | _____         |
|                                    | S ___ T ___ R ___ | _____         |

*Janet M. Stamb*  
REGISTER OF DEEDS

Register of Deeds Stamp & File Number

4. Lot No. \_\_\_\_\_, Recorded Plat \_\_\_\_\_  
5. Private Claims \_\_\_\_\_

I, Ronald Bischer, in a field survey on Sept 10 19 97 do hereby state that under requirements of P.A. 74, Michigan P.A. of 1970, the corner points mentioned in lines 1 and 2 above were in conformance with regulations and rules therefore as required in the current manual of survey instructions of the United States Department of the Interior, Bureau of Land Management or by a decree of a Court of Law and/or that the corner points mentioned in lines 3, 4 and 5 above were in conformance with the rules of the Michigan Board of Land Surveyors or by a Decree of a Court of Law; established, re-established, monumented, recovered, found as expressed below:


NOTE: Not more than 2 corners, all in the same town and range, may be recorded on this certificate.

|    | A | B  | C | D  | E | F  | G | H  | I | J  | K | L  | M |
|----|---|----|---|----|---|----|---|----|---|----|---|----|---|
| 1  |   |    |   |    |   |    |   |    |   |    |   |    |   |
| 2  |   | 6  |   | 5  |   | 4  |   | 3  |   | 2  |   | 1  |   |
| 3  |   |    |   |    |   |    |   |    |   |    |   |    |   |
| 4  |   | 7  |   | 8  |   | 9  |   | 10 |   | 11 |   | 12 |   |
| 5  |   |    |   |    |   |    |   |    |   |    |   |    |   |
| 6  |   | 18 |   | 17 |   | 16 |   | 15 |   | 14 |   | 13 |   |
| 7  |   |    |   |    |   |    |   |    |   |    |   |    |   |
| 8  |   | 19 |   | 20 |   | 21 |   | 22 |   | 23 |   | 24 |   |
| 9  |   |    |   |    |   |    |   |    |   |    |   |    |   |
| 10 |   | 30 |   | 29 |   | 28 |   | 27 |   | 26 |   | 25 |   |
| 11 |   |    |   |    |   |    |   |    |   |    |   |    |   |
| 12 |   | 31 |   | 32 |   | 33 |   | 34 |   | 35 |   | 36 |   |
| 13 |   |    |   |    |   |    |   |    |   |    |   |    |   |

A. Description of original monument and accessories and/or subsequent restoration:

K-10  
GLO Notes  
Alfred Millerd  
Set Post  
Cedar 16" S45° E 9 lks  
Cedar 5" N60° W 32 lks

1989 Norman Quaine #33984  
Found 1/2" Rod placed cap #15410 on top  
Set three witnesses

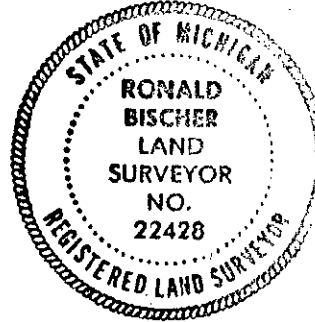

B. Description of corner evidence found and/or method applied in restoring or reestablishing corner:

K-10  
Found 1/2" Rod and Cap #33984  
and Quaines three witnesses

SURVEY & REMONUMENTATION

JAN 14 1998

SECTION

C. Description of monument for corner and accessories established to perpetuate locating the position of the corner:

K-10  
1/2" Rod and Cap #33984  
S81° W 46.82' 10" Maple Quaine witness  
N55° E 36.44' 10" Aspen Quaine witness  
East 26.13' Fence Cor. Quaine witness  
West 33.00' 1/2" Rod and Cap #33984

Ratified by Peer Group  
in accordance with P.A. 345  
Chairman *Norman Quaine*  
Date *10/30/97*

Signed by Ronald R. Bischer  
Surveyor's Michigan License No. 22428

Date Oct. 8, 1997