

325-138

1997 PRESQUE ISLE COUNTY, STATE OF MICHIGAN REMONUMENTATION

PRESQUE ISLE COUNTY  
RECORDED

LAND CORNER RECORDATION CERTIFICATE  
Filing Requirement of Act 74, Mich. P.A. 1970

97 DEC 22 AM 9:55

For corners in

<u>Presque Isle</u> (County)	Located In:	Corner Code #
1. Public Land Survey	T <u>34</u> N R <u>5E</u>	<u>K-12</u>
	T___R___	_____
	T___R___	_____
	T___R___	_____
2. Property Controlling in Section	S___T___R___	_____
	S___T___R___	_____
3. Miscellaneous Property in Sec.	S___T___R___	_____
	S___T___R___	_____

*Janet M. Lamb*  
REGISTER OF DEEDS

Register of Deeds Stamp & File Number

4. Lot No. \_\_\_\_\_, Recorded Plat \_\_\_\_\_  
5. Private Claims \_\_\_\_\_

I, Ronald Bischer, in a field survey on Sept 10 19 97 do hereby state that under requirements of P.A. 74, Michigan P.A. of 1970, the corner points mentioned in lines 1 and 2 above were in conformance with regulations and rules therefore as required in the current manual of survey instructions of the United States Department of the Interior, Bureau of Land Management or by a decree of a Court of Law and /or that the corner points mentioned in lines 3, 4 and 5 above were in conformance with the rules of the Michigan Board of Land Surveyors or by a Decree of a Court of Law; established, re-established, monumented, recovered, found as expressed below:

NOTE: Not more than 2 corners, all in the same town and range, may be recorded on this certificate.

1	A	B	C	D	E	F	G	H	I	J	K	L	M
2	6		5		4		3		2		1		
3													
4	7		8		9		10		11		12		
5													
6	18		17		16		15		14		13		
7													
8	19		20		21		22		23		24		
9													
10	30		29		28		27		26		25		
11													
12	31		32		33		34		35		36		
13													

A. Description of original monument and accessories and/or subsequent restoration:

K-12  
GLO Notes  
Alfred Millerd  
set Post  
Tamarack 10" S66° E 34 lks  
Spruce 8" N15° W 7 lks

1989 Norman Quaine #33984  
Set 1/2" rod and Cap #15410  
and three witnesses


B. Description of corner evidence found and/or method applied in restoring or reestablishing corner:

K-12  
Found 1/2" rod and cap #15410  
and three Quaine witnesses

**SURVEY &  
REMONUMENTATION**

JAN 14 1998

SECTION

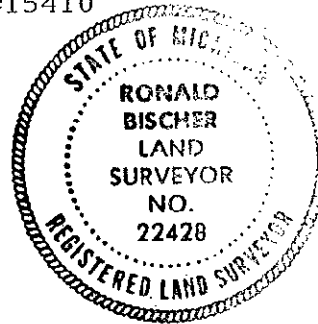

C. Description of monument for corner and accessories established to perpetuate locating the position of the corner:

K-12  
1/2" Rod and Cap #15410

N01° E	4.65'	18" Tamarack	Quaine witness
S42° E	8.58'	8" Cedar	Quaine witness
N77° W	19.27'	12" Cedar	Quaine witness
S35° W	29.78'	7" Tamarack	

Ratified by Peer Group  
in accordance with P.A. 345  
Chairman Norman J. Quaine  
Date 10/30/97

Signed by Ronald R. Bischer  
Surveyor's Michigan License No. 22428

Date Oct. 8, 1997