

LIGER 325 PAGE 192

LAND CORNER RECORDATION CERTIFICATE  
Filing Requirement of Act 74, Mich. P.A. 1970

97 DEC 23 AM 11:18

For corners in

Presque Isle (County)	Located In:	Corner Code #
1. Public Land Survey	T 34N R 5E	L-3
	T R	
	T R	
	T R	
2. Property Controlling in Section	S T R	
	S T R	
3. Miscellaneous Property in Sec.	S T R	
	S T R	

*Janet M. Stumpf*  
REGISTER OF DEEDS

SURVEY &  
REMONUMENTATION

JAN 14 1998

Register of Deeds Section File Number

4. Lot No. \_\_\_\_\_, Recorded Plat \_\_\_\_\_  
5. Private Claims \_\_\_\_\_

I, Delmer E. Porter in a field survey on 4-8, 1997 do hereby state that under requirements of P.A. 74, Michigan P.A. of 1970, the corner points mentioned in lines 1 and 2 above were in conformance with regulations and rules therefore as required in the current manual of survey instructions of the United States Department of the Interior, Bureau of Land Management or by a decree of a Court of Law and/or that the corner points mentioned in lines 3, 4 and 5 above were in conformance with the rules of the Michigan Board of Land Surveyors or by a Decree of a Court of Law; established, re-established, monumented, recovered, found as expressed below:

NOTE: Not more than 2 corners, all in the same town and range, may be recorded on this certificate.

	A	B	C	D	E	F	G	H	I	J	K	L	M
1													
2	6		5		4		3		2			1	
3													
4	7		8		9		10		11			12	
5													
6	18		17		16		15		14			13	
7													
8	19		20		21		22		23			24	
9													
10	30		29		28		27		26			25	
11													
12	31		32		33		34		35			36	
13													

A. Description of original monument and accessories and/or subsequent restoration:

L-3  
GLO Notes Set. Qr. Sec. Post  
Alfred Millard Beech 5" For Corner  
July 8, 1856 Beech 10" East 16 Lk

D. Porter #15410 Set 1/2" Pipe @ FE  
Act 74 Filing Corner Post  
Aug. 8, 1974 S80°W 18.50' 8" Maple  
L. 1 Pg 61 S10°E 11.19' 8"  
Basswood

"Continued on Back"

B. Description of corner evidence found and/or method applied in restoring or reestablishing corner:

L-3  
Fd. 1/2" Pipe in FE Line E-W  
Corner @ Old Stump FE Cor.  
S85°W 18.61' 12" Maple  
S63°E 10.69' 13" Basswood  
S11°W 11.33' 15" Basswood  
S09°W 25.55' 4" Maple


Ratified by Peer Group  
in accordance with P.A. 345

Chairman *Norman J. Quinn*

Date 12/04/97

C. Description of monument for corner and accessories established to perpetuate locating the position of the corner:

L-3  
1/2" Pipe in FE Line E-W  
Corner @ Old Stump FE Cor.  
S85°W 18.61' 12" Maple  
S63°E 10.69' 13" Basswood  
S11°W 11.33' 15" Basswood  
S09°W 25.55' 4" Maple

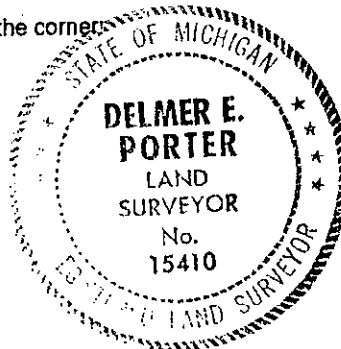

Signed by *Delmer E. Porter*  
Surveyor's Michigan License No. 15410

Date 12/18/97

A continued:

R.E. Alanen, #12042  
 Act 132 Survey  
 Aug. 3, 1976  
 Rec. Aug. 4, 1976  
 L. 213 Pg. 602

Fd. 3/4" Re-Bar  
 10" Maple West 18.1'  
 Basswood East 9.9'  
 Basswood South 8.2'

Same Survey Recorded  
 Oct. 13, 1976  
 L. 214 Pg. 673

J. Beck, #21559  
 Act 132 Survey  
 Oct. 24, 1994  
 No Recorded Date  
 L. 313 Pg. 373

1/2" Pipe @ N. Face Fence Post  
 S80°W 18.53' 10" Maple in Clump  
 S60°W 33.89' 12" Basswood  
 S65°E 10.70' 14" Basswood  
 S05°W 25.57' 6" Maple  
 S12°W 11.31' 14" Basswood

Jim Beck, #21559  
 Act 74 Filing  
 Dec. 2, 1994  
 L. 312 Pg. 216

1/2" Pipe @ N. Face Fence Post  
 S80°W 18.53' 10" Maple In Clump  
 S60°W 33.89' 12" Basswood  
 S65°E 10.70' 14" Basswood  
 S05°W 25.57' 6" Maple  
 S12°W 11.31' 14" Basswood