

UBER 325 PAGE 196

LAND CORNER RECORDATION CERTIFICATE
Filing Requirement of Act 74, Mich. P.A. 1970

97 DEC 23 AM 11:18

For corners in

Presque Isle (County)	Located In:	Corner Code #
1. Public Land Survey	T 34N R 5E	L-7
	T R	
	T R	
	T R	
2. Property Controlling in Section	S T R	
	S T R	
3. Miscellaneous Property in Sec.	S T R	
	S T R	

Jane M. Lamb
REGISTER OF DEEDS
SURVEY &
REMONUMENTATION

JAN 14 1998

SECTION

Register of Deeds Stamp & File Number

4. Lot No. _____, Recorded Plat _____
5. Private Claims _____

I, Delmer E. Porter in a field survey on 3-31, 1997 do hereby state that under requirements of P.A. 74, Michigan P.A. of 1970, the corner points mentioned in lines 1 and 2 above were in conformance with regulations and rules therefore as required in the current manual of survey instructions of the United States Department of the Interior, Bureau of Land Management or by a decree of a Court of Law and/or that the corner points mentioned in lines 3, 4 and 5 above were in conformance with the rules of the Michigan Board of Land Surveyors or by a Decree of a Court of Law; established, re-established, monumented, recovered, found as expressed below:

NOTE: Not more than 2 corners, all in the same town and range, may be recorded on this certificate.

	A	B	C	D	E	F	G	H	I	J	K	L	M
1													
2	6		5		4		3		2		1		
3													
4	7		8		9		10		11		12		
5													
6	18		17		16		15		14		13		
7													
8	19		20		21		22		23		24		
9													
10	30		29		28		27		26		25		
11													
12	31		32		33		34		35		36		
13													

A. Description of original monument and accessories and/or subsequent restoration:

L-7
GLO Notes Set Qr. Section Post
Alfred Millard Cedar 10" N40°E 23 Lks
July 5, 1856 Sugar 10" S55°W 31 Lks

D. Porter #15410 Set 1/2" Rod by S.P.
Act 74 Filing North 36.60' FE Cor
Dec. 12, 1977 N28°W 55.36' 4" Cedar
L. 1 Pg. 211 S52°W 45.89' FE Cor

"Continued on Back"


B. Description of corner evidence found and/or method applied in restoring or reestablishing corner:

L-7
Fd. 1/2" Rod in Mon Box
2.1' North to Road C/L
S61°W 55.07' P. Pole
N22°W 35.35' FE Cor.
N05°E 54.92' 7" Cedar

Ratified by Peer Group
in accordance with P.A. 345
Chairman *Norman Quinn*
Date 12/04/97

C. Description of monument for corner and accessories established to perpetuate locating the position of the corner:

L-7
1/2" Rod in Mon Box
2.1' North to Road C/L
S61°W 55.07' P. Pole
N22°W 35.35' FE Cor.
N05°E 54.92' 7" Cedar
N58°E 50.47' 4" Elm

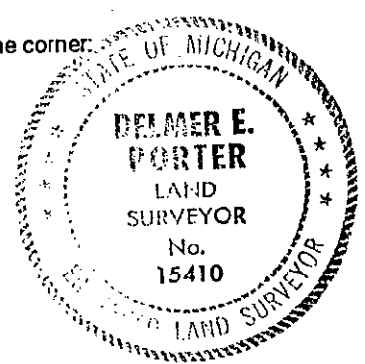

Signed by *Delmer E. Porter*
Surveyor's Michigan License No. 15410

Date 12/18/97

A Continued:

D. Porter, #15410	1/2" Rod
Act 132 Survey	North 36.60' FE Cor
Nov. 7, 1977	N28°W 55.36' 4" Cedar
Rec. Dec. 27, 1977	S52°W 45.89' FE Cor
L. 220 Pg. 601	
P.I. County	Replaced 1/2" Rod with
Local Remon	Conc Mon - Brass Cap
Nov. 9, 1979	S60°W 54.81' P. Pole
	N28°W 55.38' 4" Cedar
	North 36.82' FE Cor.
J. Beck #21559	North 36.4' FE Cor.
Act 132 Survey	N28°W 55.36' 4" Cedar
Aug. 30, 1987	S52°W 45.89' FE Cor.
Rec. Oct. 29, 1987	No mention of physical cor.
L. 277 Pg. 936	
D. MacNeill, #19237	Fd. 1/2" Re-rod
Act 132 Survey	
June 14, 1989	
No recorded Date	
L. 293, Pg. 094	