

206

PRESQUE ISLE COUNTY RECORDS

97 DEC 23 AM 11:17

LAND CORNER RECORDATION CERTIFICATE  
Filing Requirement of Act 74, Mich. P.A. 1970

For corners in

<u>Presque Isle</u> (County)	Located in:	Corner Code #
1. Public Land Survey	T <u>34</u> N <u>5</u> E	<u>M-3</u>
	T <u>   </u> R <u>   </u>	<u>   </u>
	T <u>   </u> R <u>   </u>	<u>   </u>
	T <u>   </u> R <u>   </u>	<u>   </u>
2. Property Controlling in Section	S <u>   </u> T <u>   </u> R <u>   </u>	<u>   </u>
	S <u>   </u> T <u>   </u> R <u>   </u>	<u>   </u>
3. Miscellaneous Property in Sec.	S <u>   </u> T <u>   </u> R <u>   </u>	<u>   </u>
	S <u>   </u> T <u>   </u> R <u>   </u>	<u>   </u>
4. Lot No. _____, Recorded Plat _____		
5. Private Claims _____		

*Gene M. ...*  
REGISTER OF DEEDS

SURVEY & REMONUMENTATION

JAN 14 1998

SECTION

Register of Deeds Stamp & File Number

I, Delmer E. Porter in a field survey on 3-2, 1997 do hereby state that under requirements of P.A. 74, Michigan P.A. of 1970, the corner points mentioned in lines 1 and 2 above were in conformance with regulations and rules therefore as required in the current manual of survey instructions of the United States Department of the Interior, Bureau of Land Management or by a decree of a Court of Law and/or that the corner points mentioned in lines 3, 4 and 5 above were in conformance with the rules of the Michigan Board of Land Surveyors or by a Decree of a Court of Law; established, re-established, monumented, recovered, found as expressed below:

NOTE: Not more than 2 corners, all in the same town and range, may be recorded on this certificate.

A	B	C	D	E	F	G	H	I	J	K	L	M
1												
2	6		5		4		3		2		1	
3												
4	7		8		9		10		11		12	
5												
6	10		17		16		15		14		13	
7												
8	19		20		21		22		23		24	
9												
10	30		29		28		27		26		25	
11												
12	31		32		33		34		35		36	
13												


A. Description of original monument and accessories and/or subsequent restoration:

M-3	GLO Notes	Set Post Cor of Sec 1&12	Sec. 6 Survey	Field notes do not
Alfred Millard	July 5, 1856	Tamarack 9" S32°W 5 Lk	T34N, R6E, By	indicate a physical co
		Tamarack 7" N48°W 66'	Francis Spicer	N20°W 15.51' 8" Cedar
		Old cor of Sec 1&12 644	LS#7877	West 3.05' 10" Cedar
		South & 85 Links West	9/29/62	N80°E 9.43' 10" Cedar
		Effaced		Survey was for MI
				Limestone Corporation

"Continued on Back"

B. Description of corner evidence found and/or method applied in restoring or reestablishing corner:

M-3	Porter's Survey	Found 1/2" Iron in cement
1997 Remon.	3-2-97	S44°W 25.02' 6" Cedar (Nail)
		S72°W 19.78' 18" Cedar (Nail & Tag #15410)
		S85°W 44.60' 24" W. Pine (Nail & Tag #21559)
		N08°W 27.23' 14" Cedar (Nail & Tag #15410)

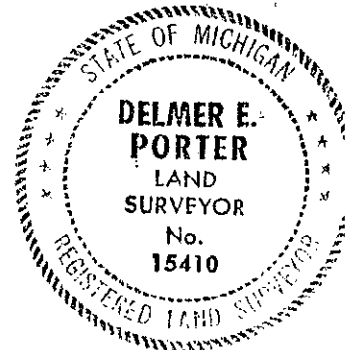

C. Description of monument for corner and accessories established to perpetuate locating the position of the corner:

M-3	1/2" Iron in Cement
	S44°W 25.02' 6" Cedar (Nail)
	S72°W 19.78' 18" Cedar (Nail & Tag #15410)
	S85°W 44.60' 24" W. Pine (Nail & Tag #21559)
	N08°W 27.23' 14" Cedar (Nail & Tag #15410)

Ratified by Peer Group  
in accordance with P.A. 345  
Chairman *Norman J. ...*  
Date 12/4/97

Signed by Delmer E. Porter  
Surveyor's Michigan License No. 15410

Date 12/18/97

"A" Continued:

Ronald R. Bischer  
LS#22428  
Porter's Survey  
Records

Found Concrete Monument  
By very old cedar stake  
All three witnesses by  
some other surveyor (U.S. Steel?)  
N23°W 15.50' 12" Cedar  
N84°W 2.92' 14" Cedar  
S80°E 9.40' 10" Cedar

P.A. 74  
Rec. 12/2/94  
James A. Beck  
#21559  
L 312 PG 216

Fd. 1/2" Iron in cement  
SW 44.60' 24" White Pine  
N20°W 15.57' 15" Cedar Stump (Nail in Blaze)  
West 2.94' 13" Cedar Stump (Nail in Blaze)  
N80°W 9.43' 12" Cedar Stump