

97 DEC 23 AM 11:17

LAND CORNER RECORDATION CERTIFICATE
Filing Requirement of Act 74, Mich. P.A. 1970

For corners in

<u>Presque Isle</u> (County)	Located In:	Corner Code #
1. Public Land Survey	<u>T34N R 5E</u>	<u>M-4</u>
	T <u> </u> R <u> </u>	<u> </u>
	T <u> </u> R <u> </u>	<u> </u>
	T <u> </u> R <u> </u>	<u> </u>
2. Property Controlling in Section	S <u> </u> T <u> </u> R <u> </u>	<u> </u>
	S <u> </u> T <u> </u> R <u> </u>	<u> </u>
3. Miscellaneous Property in Sec.	S <u> </u> T <u> </u> R <u> </u>	<u> </u>
	S <u> </u> T <u> </u> R <u> </u>	<u> </u>

John M. Lamb
REGISTER OF DEEDS

SURVEY &
REMONUMENTATION

JAN 14 1998

SECTION
Register of Deeds Stamp & File Number

4. Lot No. _____, Recorded Plat _____
5. Private Claims _____

I, Delmer E. Porter in a field survey on 3-31, 1997 do hereby state that under requirements of P.A. 74, Michigan P.A. of 1970, the corner points mentioned in lines 1 and 2 above were in conformance with regulations and rules therefore as required in the current manual of survey instructions of the United States Department of the Interior, Bureau of Land Management or by a decree of a Court of Law and/or that the corner points mentioned in lines 3, 4 and 5 above were in conformance with the rules of the Michigan Board of Land Surveyors or by a Decree of a Court of Law; established, re-established, monumented, recovered, found as expressed below:

NOTE: Not more than 2 corners, all in the same town and range, may be recorded on this certificate.

1	A	B	C	D	E	F	G	H	I	J	K	L	M
2		6		5		4		3		2		1	
3													
4		7		8		9		10		11		12	
5													
6		18		17		16		15		14		13	
7													
8		19		20		21		22		23		24	
9													
10		30		29		28		27		26		25	
11													
12		31		32		33		34		35		36	
13													

A. Description of original monument and accessories and/or subsequent restoration:

M-4
GLO Notes Set Qr. Sec.
Alfred Millard Beech 7" N55°W 4 Lk
July 5, 1856 Beech 20" S25°E 10 Lk.
Old Qr. Cor 6.00 Lks S.
& 88 Lks West effaced

D. Porter, #15410 Set 1/2" Rod &
Act 74 Filing Cap from MDSH
Aug. 8, 1974 Witnesses
N38°W 51.43' P.Pole
S50°W 73.20' T.Pole

Note: No Liber or Pg recorded on document.
"Continued on Back"

B. Description of corner evidence found and/or method applied in restoring or reestablishing corner:

M-4
Fd. 1/2" Rod in Mon Box
S53°W 77.92' FE Cor
S73°W 74.38' 6" Elm
N62°W 61.67' 22" Elm
N33°W 51.41' P. Pole


Ratified by Peer Group
in accordance with P.A. 345

Chairman *Norman J. Quinn*

Date 12/10/97

C. Description of monument for corner and accessories established to perpetuate locating the position of the corner:

M-4
1/2" Rod in Mon Box
S53°W 77.92' FE Cor
S73°W 74.38' 6" Elm
N62°W 61.67' 22" Elm
N33°W 51.41' P. Pole
S51°W 79.51' NGS Mon

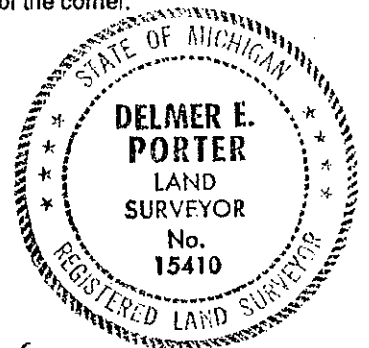

Signed by *Delmer E. Porter*
Surveyor's Michigan License No. 15410

Date 12/18/97

A Continued:

D. Porter, #15410 Act 132 Survey Aug 8, 1974 Rec Aug 12, 1974 L 206 Pg 228	1/2" Rod N38°W 51.43' P. Pole S50°W 73.20' T. Pole
D. Porter Act 132 Survey Sept 8, 1975 Rec Oct 24, 1975 L 209 Pg 882	Same
D. Porter, #15410 Act 132 Survey Sept 8, 1975 Rec Oct 24, 1975 L 209, Pg 881	Same
D. Porter, #15410 Act 132 Survey Sept 30, 1975 Rec Oct 24, 1975 L 209, Pg 883	Same
D. MacNeill, #19237 Act 132 Survey June 15, 1977 Rec July 25, 1979 L 231 Pg 302	1/2" Capped Re-rod N38°W 51.43' P.P. S50°W 73.20' T.P.
D. MacNeill, #19237 Act 132 Survey June 23, 1981 Rec Aug 1, 1981 L 241 Pg 364	Labels Corner. No Mention of Corner. No Wit
J. Beck, #21559 Act 132 Survey Oct 24, 1994 No Recorded Date L 313 Pg 373	1/2" Iron Rod in Mon Box N64°W 47.00' St. Sign S48°W 80.52' Top Center Wit Marker for Vertical Control Mon S73°E 30.17' N. Leg of Rd. Sign Post S68°W 74.32' P.S. 21559 Tag in 6" Elm
N. Quaine, #33984 Act 74 Filing May 31, 1996 L 318 Pg 649	Fd 1/2" Rod in Mon Box N33°W 51.41' P. Pole Left 1/2" Rod in Mon Box N33°W 51.41' P. Pole N62°W 61.67' 22" Elm S73°W 74.38' 6" Elm S53°W 77.92' FE Cor