

LIBER 325 PAGE 176

LAND CORNER RECORDATION CERTIFICATE
Filing Requirement of Act 74, Mich. P.A. 1970

PRESQUE ISLE COUNTY
RECORDED

97 DEC 23 AM 11:17

For corners in

Presque Isle (County)	Located In:	Corner Code #
1. Public Land Survey	T 34N R 5E	M-5
	T R	
	T R	
	T R	
2. Property Controlling in Section	S T R	
	S T R	
3. Miscellaneous Property in Sec.	S T R	
	S T R	

Janice M. Lamb
REGISTER OF DEEDS

SURVEY &
REMONUMENTATION

FEB 20 1998

SECTION
Register of Deeds Stamp & File Number

4. Lot No. _____, Recorded Plat _____
5. Private Claims _____

I, Delmer E. Porter, in a field survey on 3-31, 1997 do hereby state that under requirements of P.A. 74, Michigan P.A. of 1970, the corner points mentioned in lines 1 and 2 above were in conformance with regulations and rules therefore as required in the current manual of survey instructions of the United States Department of the Interior, Bureau of Land Management or by a decree of a Court of Law and /or that the corner points mentioned in lines 3, 4 and 5 above were in conformance with the rules of the Michigan Board of Land Surveyors or by a Decree of a Court of Law; established, re-established, monumented, recovered, found as expressed below:

NOTE: Not more than 2 corners, all in the same town and range, may be recorded on this certificate.

	A	B	C	D	E	F	G	H	I	J	K	L	M
1													
2	6		5		4		3		2		1		
3													
4	7		8		9		10		11		12		
5													
6	18		17		16		15		14		13		
7													
8	19		20		21		22		23		24		
9													
10	30		29		28		27		26		25		
11													
12	31		32		33		34		35		36		
13													

A. Description of original monument and accessories and/or subsequent restoration:

M-5
GLO Notes Set Post Cor of Sec 12&13
Alfred Millard Hemlock 12" S40°W 31 Lk
July 5, 1856 Hemlock 18" N25°W 47 Lk
Old Corner 6.70 South &
105 West - effaced

D: Porter, #15410 Fd. 1 1/2" Bar
Act 74 Filing West 23.03' FE Co
Aug. 8, 1974 South 26.33' FE Co
L. 1 Pg. 61 S33°E 30.84' East
Gate Post

"Continued on Back"

B. Description of corner evidence found and/or method applied in restoring or reestablishing corner:


M-5
Fd. 1/2" Rod & Cap #33984
S07°W 27.38' FE Cor.
N29°W 23.85' 4" Aspen
N14°W 44.18' 12" Aspen in Cluster
S23°E 31.76' Gate Post

Ratified by Peer Group
in accordance with P.A. 345

Chairman *Norman J. Quinn*
Date 12/04/97

C. Description of monument for corner and accessories established to perpetuate locating the position of the corner:

M-5
1/2" Rod & Cap #33984
S07°W 27.38' FE Cor.
N29°W 23.85' 4" Aspen
N14°W 44.18' 12" Aspen in Cluster
S23°E 31.76' Gate Post

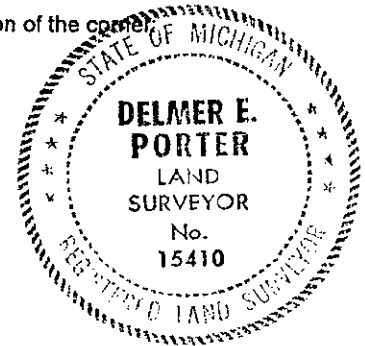

Signed by *Delmer E. Porter*
Surveyor's Michigan License No. 15410

Date 12/18/97

A Continued:

D. Porter, #15410
Act 132 Survey
Sept. 8, 1975
Rec. Oct. 24, 1975
L. 209 Pg. 881

Fd. 1 1/2" Bar
West 23.03' FE Cor.
South 26.33' FE Cor.
S33° E 30.84' Gate Post

May 31, 1996
74 Filing
Norman J. Quaine
#33984
L. 318 Pg. 649

Fd. 1/2" Rod, placed Cap #33984 on Rod
S23° E 31.76' Gate Post
S07° W 27.38' FE Cor.
Left 1/2" Rod & Cap #33984
N14° W 44.18' 12" Aspen in Cluster
N29° W 23.85' 4" Aspen
S07° W 27.38' FE Cor.
S23° E 31.76' Gate Post

SURVEY &
DOCUMENTATION

JAN 22 2001

SECTION