

LIBER 325 PAGE 178

LAND CORNER RECORDATION CERTIFICATE 97 DEC 23 AM 11:17
Filing Requirement of Act 74, Mich. P.A. 1970

For corners in

<u>Presque Isle</u> (County)	Located In:	Corner Code #
1. Public Land Survey	T34N R 5E	M-6
	T___ R___	_____
	T___ R___	_____
	T___ R___	_____
2. Property Controlling in Section	S___ T___ R___	_____
	S___ T___ R___	_____
3. Miscellaneous Property in Sec.	S___ T___ R___	_____
	S___ T___ R___	_____

Janet M. Lamb
REGISTER OF DEEDS

SURVEY &
REMONUMENTATION

JAN 14 1998

SECTION
Register of Deeds Stamp & File Number

4. Lot No. _____, Recorded Plat _____
5. Private Claims _____

I, Delmer E. Porter, in a field survey on 3-27, 19 97 do hereby state that under requirements of P.A. 74, Michigan P.A. of 1970, the corner points mentioned in lines 1 and 2 above were in conformance with regulations and rules therefore as required in the current manual of survey instructions of the United States Department of the Interior, Bureau of Land Management or by a decree of a Court of Law and/or that the corner points mentioned in lines 3, 4 and 5 above were in conformance with the rules of the Michigan Board of Land Surveyors or by a Decree of a Court of Law, established, re-established, monumented, recovered, found as expressed below:

NOTE: Not more than 2 corners, all in the same town and range, may be recorded on this certificate.

	A	B	C	D	E	F	G	H	I	J	K	L	M
1													
2	6	5	4	3	2	1							
3													
4	7	8	9	10	11	12							
5													
6	18	17	16	15	14	13							
7													
8	19	20	21	22	23	24							
9													
10	30	29	28	27	26	25							
11													
12	31	32	33	34	35	36							
13													

A. Description of original monument and accessories and/or subsequent restoration:

M-6			
GLO Notes	Set Qr. Sec. Post	R. Bischer #22428	Fd. 8" Spike
Alfred Millard	Cedar 10" N40°E 23 Lk	Act 74 Filing	Replaced w/ 1/2" Rod
July 5, 1856	Sugar 10" S55°W 31 Lk	Dec. 12, 1979	N22°W 76.33' 4" Cedar
	Old Qr. Cor 6.50 S &	L. 1 Pg. 437	S34°W 54.23' 16" Birch
	85 Links W - effaced		S34°E 107.75' 8"
			Hemlock

B. Description of corner evidence found and/or method applied in restoring or reestablishing corner:


M-6
Fd. 1/2" Rod & Cap #15410
Between Fence Post & Fence Corner E-N-S
Underneath Old Metal Bucket
S37°W 54.34' 16" Birch (Dead)

Ratified by Peer Group
in accordance with P.A. 345

Chairman *Norman J. Owen*
Date 12/04/97

C. Description of monument for corner and accessories established to perpetuate locating the position of the corner:

M-6
1/2" Rod & Cap #15410
Between Fence Post & Fence Corner E-N-S
Underneath Old Metal Bucket
S37°W 54.34' 16" Birch (Dead)
S32°E 6.47' 4" Apple
N78°W 25.90' 7" Aspen
N23°E 88.03' 10" Aspen
S16°W 19.61' 4" Cedar

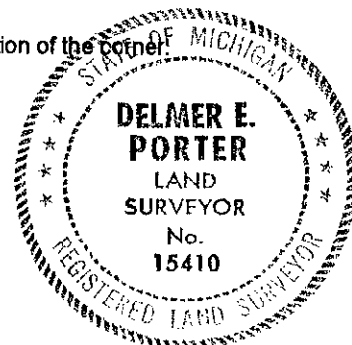

Signed by *Delmer E. Porter*
Surveyor's Michigan License No. 15410

Date 12/18/97