

260

LAND CORNER RECORDATION CERTIFICATE 87 DEC 23 AM 11:17  
Filing Requirement of Act 74, Mich. P.A. 1970

For corners in

Presque Isle (County)	Located In:	Corner Code #
1. Public Land Survey	T34NR 5E	M-9
	T R	
	T R	
	T R	
2. Property Controlling in Section	S T R	
	S T R	
3. Miscellaneous Property in Sec.	S T R	
	S T R	

*Gene M. Stambaugh*  
REGISTER OF DEEDS

**SURVEY &  
REMONUMENTATION**

**JAN 14 1998**

**SECTION**

Register of Deeds Stamp & File Number

4. Lot No. \_\_\_\_\_, Recorded Plat \_\_\_\_\_  
5. Private Claims \_\_\_\_\_

I, Delmer E. Porter in a field survey on 4-1, 1997 do hereby state that under requirements of P.A. 74, Michigan P.A. of 1970, the corner points mentioned in lines 1 and 2 above were in conformance with regulations and rules therefore as required in the current manual of survey instructions of the United States Department of the Interior, Bureau of Land Management or by a decree of a Court of Law and /or that the corner points mentioned in lines 3, 4 and 5 above were in conformance with the rules of the Michigan Board of Land Surveyors or by a Decree of a Court of Law; established, re-established, monumented, recovered, found as expressed below:

NOTE: Not more than 2 corners, all in the same town and range, may be recorded on this certificate.

	A	B	C	D	E	F	G	H	I	J	K	L	M
1													
2	6		5		4		3		2		1		
3													
4	7		8		9		10		11		12		
5													
6	18		17		16		15		14		13		
7													
8	19		20		21		22		23		24		
9													
10	30		29		28		27		26		25		
11													
12	31		32		33		34		35		36		
13													

A. Description of original monument and accessories and/or subsequent restoration:

M-9		
GLO Notes	Set Post Cor of Sec 24&25	R. Bischer #22428 Set 1/2" Rod From
Alfred Millard	Sugar 6" N48°W 18 Lk	Act 74 Filing Fence
July 5, 1856	Hemlock 20" S75°W 12 Lk	Dec. 28, 1982 N04° E 52.41' 8" App
	Old Corner 1.32' West &	L. 1 Pg. 593 N31° E 57.78' 7" Ced
	79 Lks North - effaced	L. 1 Pg. 598 N39° E 13.72' 4" App

"Continued on Back"


B. Description of corner evidence found and/or method applied in restoring or reestablishing corner:

M-9  
Fd. 1/2" Rod & Cap #21559  
S76° E 49.70' 5" Cedar  
S06° W 33.14' 1/2" Rod & Cap #21559  
S55° W 102.23' NE Cor. Hse. Foundation

Ratified by Peer Group  
in accordance with P.A. 345  
Chairman *Norman J. Quinn*  
Date 12/04/97

C. Description of monument for corner and accessories established to perpetuate locating the position of the corner:

M-9  
1/2" Rod & Cap #21559  
S76° E 49.70' 5" Cedar  
S06° W 33.14' 1/2" Rod & Cap #21559  
N55° W 102.23' NE Cor. Hse. Foundation  
N04° E 52.72' 12" Apple

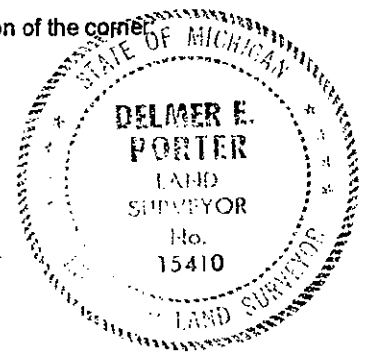

Signed by *Delmer E. Porter*  
Surveyor's Michigan License No. 15410

Date 12/18/97

## A Continued:

E. Lewis, #27452  
 Alt 132 Survey  
 Jan. 28, 1984  
 No Recorded Date  
 L. 263 Pg. 002

Existing 1/2" Rod  
 N30° E 57.35' 10" Cedar  
 S15° E 82.90' 10" Aspen

J. Beck, #21559  
 Act 74 Filing  
 Oct. 11, 1993  
 L. 307 Pg. 302

Fd. 1/2" Rod & Porter's Survey Cap  
 1' Deep under new road bed  
 N04° E 52.41' 9" Apple  
 Raised w/ 1/2" Rod & Cap #21559  
 N04° E 52.41' 9" Apple  
 S42° E 49.60' 5" Cedar  
 South On Sec Line 33.00' 1/2" Rod &  
 Cap #21559  
 S50° W 102.05' NE Cor. Hse. Foundation

J. Beck, #21559  
 Act 132 Survey  
 Sept. 30, 1993  
 Rec. Jan. 13, 1994  
 L. 308 Pg. 320

Fd. 1/2" Iron under 1' of Gravel  
 Set 1/2" Iron & PS 21559 Cap Above  
 N04° E 52.41' 8" Apple  
 S50° W 102.05' SE Cor House  
 S42° E 49.60' 5" Cedar  
 South 33.0' 1/2" Iron & PS 21559 Cap  
 on Section Line