

LIBER **325** PAGE **188**

LAND CORNER RECORDATION CERTIFICATE
Filing Requirement of Act 74, Mich. P.A. 1970

97 DEC 23 AM 11:18

For corners in

<u>Presque Isle</u> (County)	Located In:	Corner Code #
1. Public Land Survey	T <u>34</u> N R <u>5</u> E	<u>M-12</u>
	T <u> </u> R <u> </u>	<u> </u>
	T <u> </u> R <u> </u>	<u> </u>
	T <u> </u> R <u> </u>	<u> </u>
2. Property Controlling in Section	S <u> </u> T <u> </u> R <u> </u>	<u> </u>
	S <u> </u> T <u> </u> R <u> </u>	<u> </u>
3. Miscellaneous Property in Sec.	S <u> </u> T <u> </u> R <u> </u>	<u> </u>
	S <u> </u> T <u> </u> R <u> </u>	<u> </u>

Lucie M. Lamb
REGISTER OF DEEDS

**SURVEY &
REMONUMENTATION**

JAN 14 1998

SECTION
Register of Deeds Stamp & File Number

4. Lot No. _____, Recorded Plat _____
5. Private Claims _____

I, Delmer E. Porter, in a field survey on 3-27, 1997 do hereby state that under requirements of P.A. 74, Michigan P.A. of 1970, the corner points mentioned in lines 1 and 2 above were in conformance with regulations and rules therefore as required in the current manual of survey instructions of the United States Department of the Interior, Bureau of Land Management or by a decree of a Court of Law and /or that the corner points mentioned in lines 3, 4 and 5 above were in conformance with the rules of the Michigan Board of Land Surveyors or by a Decree of a Court of Law, established, re-established, monumented, recovered, found as expressed below.

NOTE: Not more than 2 corners, all in the same town and range, may be recorded on this certificate.

	A	B	C	D	E	F	G	H	I	J	K	L	M
1													
2	6		5			4		3		2		1	
3													
4	7		8			9		10		11		12	
5													
6	18		17			16		15		14		13	
7													
8	19		20			21		22		23		24	
9													
10	30		29			28		27		26		25	
11													
12	31		32			33		34		35		36	
13													

A. Description of original monument and accessories and/or subsequent restoration:
M-12

GLO Notes Set Qr. Sec Post
Alfred Millard Hemlock 10" N30° E 2 Lk
July 5, 1856 Beech 15" S55° W 30 Lk
Old Qr. Cor 23 Lk West
& 50 Lk North - effaced

R. Bischer, #22428 Set 1/2" Rod by S.
Act 74 Filing N44° W 41.62' FE Pc
Dec. 20, 1982 S73° E 73.62' FE Pc
L. 1 Pg. 597 S69° W 35.72' FE Pc

"Continued on Back"

B. Description of corner evidence found and/or method applied in restoring or reestablishing corner:


M-12
Fd. 1/2" Rod & Cap #15410
1.0' Below Road Surface
10' East of Road C/L
15' North of Old FE Line to East
On South Edge of Field Access Drive
S72° E 73.66' FE Post

Ratified by Peer Group
in accordance with P.A. 345

Chairman *Norman J. Owen*
Date 12/18/97

C. Description of monument for corner and accessories established to perpetuate locating the position of the corner of the

M-12
1/2" Rod & Cap #15410
1.0' Below Road Surface
10' East of Road C/L
15' North of Old FE Line to East
On South Edge of Field Access Drive
S72° E 73.66' FE Post
S81° E 190.22' 10" Maple
No other witnesses available

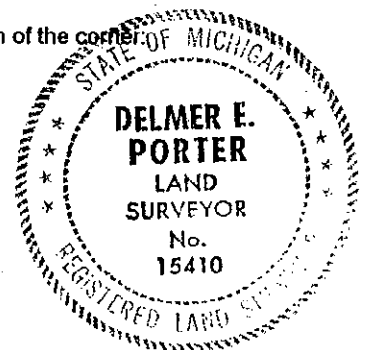

Signed by *Delmer E. Porter*
Surveyor's Michigan License No. 15410

Date 12/18/97

A Continued:

R. Bischer, #22428
Act 74 Filing
Dec. 28, 1982
L. 1 Pg. 594

N44°W 41.62' FE Post
S73°E 73.62' FE Post
S69°W 35.72' FE Post