

2672

PRESQUE ISLE COUNTY  
RECORDED

LIBER 325 PAGE 190

97 DEC 23 11:18

LAND CORNER RECORDATION CERTIFICATE  
Filing Requirement of Act 74, Mich. P.A. 1970

For corners in

Presque Isle (County)	Located In:	Corner Code #
1. Public Land Survey	34N R 5E	M-13
	T___ R___	_____
	T___ R___	_____
	T___ R___	_____
2. Property Controlling in Section	S___ T___ R___	_____
	S___ T___ R___	_____
3. Miscellaneous Property in Sec.	S___ T___ R___	_____
	S___ T___ R___	_____

*James M. Smith*  
REGISTER OF DEEDS

SURVEY &  
REMONUMENTATION

JAN 14 1998

SECTION

Register of Deeds Stamp & File Number

4. Lot No. \_\_\_\_\_, Recorded Plat \_\_\_\_\_  
5. Private Claims \_\_\_\_\_

I, Delmer E. Porter, in a field survey on 3-27, 1997 do hereby state that under requirements of P.A. 74, Michigan P.A. of 1970, the corner points mentioned in lines 1 and 2 above were in conformance with regulations and rules therefore as required in the current manual of survey instructions of the United States Department of the Interior, Bureau of Land Management or by a decree of a Court of Law and /or that the corner points mentioned in lines 3, 4 and 5 above were in conformance with the rules of the Michigan Board of Land Surveyors or by a Decree of a Court of Law; established, re-established, monumented, recovered, found as expressed below:

NOTE: Not more than 2 corners, all in the same town and range, may be recorded on this certificate.

	A	B	C	D	E	F	G	H	I	J	K	L	M
1													
2		6		5		4		3		2		1	
3													
4		7		8		9		10		11		12	
5													
6		16		17		16		15		14		13	
7													
8		19		20		21		22		23		24	
9													
10		30		29		28		27		26		25	
11													
12		31		32		33		34		35		36	
13													

A. Description of original monument and accessories and/or subsequent restoration:

M-13			
GLO Notes	Set Post @ Int Cor Twps	R. Bischer #22428	Fd PK Nail in Rd. C/L
John Hodgson	33 & 34N, R5 & 6E	Act 74 Filing	N32°W 47.02' T. Pole
May 12, 1840	Beech 8" N54°E 15 Lk	Dec. 20, 1982	S46°W 48.55' FE Post
	Sugar 10" N83°W 22 Lk	L. 1 Pg. 594	S36°W 50.31' P. Pole
			Note: PK Nail to be replaced by 1/2" Rod Summer 1983

"Continued on Back"


B. Description of corner evidence found and/or method applied in restoring or reestablishing corner:

M-13  
Fd. 1/2" Rod & Cap #15410 in Mon. Box  
@ Road C/L - C/L Int.  
S38°W 50.48' P. Pole

Ratified by Peer Group  
in accordance with P.A. 345  
Chairman *Thomas J. Quinn*  
Date 12/04/97

C. Description of monument for corner and accessories established to perpetuate locating the position of the corner:

M-13  
1/2" Rod & Cap #15410 in Mon Box  
@ Road C/L - C/L Int.  
N02°E 256.48' P. Pole  
S38°W 50.48' P. Pole  
S57°W 120.72' 6" Cedar  
S74°W 104.03' 3" Cedar

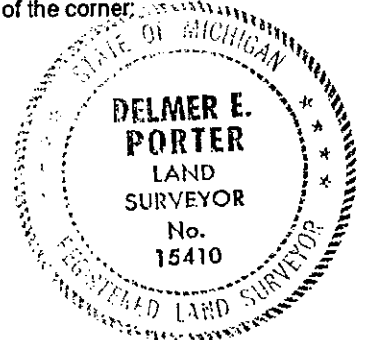

Signed by *Delmer E. Porter*  
Surveyor's Michigan License No. 15410

Date 12/18/97

A Continued:

R. Bischer, #22428  
Act 74 Filing  
Dec. 20, 1982  
L. 1 Pg. 597

Fd. PK Nail in Rd. C/L  
N32°W 47.02' T. Pole  
S46°W 48.55' FE Post  
S36°W 50.31' P. Pole  
Note: PK Nail to be replaced  
by 1/2" Rod in Summer 1983

R. Bischer, #22428  
Act 74 Filing  
Dec. 28, 1982  
L. 1 Pg. 599

Same as above