

LAND CORNER RECORDATION CERTIFICATE

FILING REQUIREMENT OF ACT 74, MICH. P.A.1970

FOR CORNERS OF -:	LOCATED IN -:	CORNER CODE NUMBER
1. PUBLIC LAND SURVEY	T. 35 N. R. 3 E.	B-1; B-3
2. PROPERTY CONTROLLING IN SECTION	T. S. R. E. W.	
3. MISCELLANEOUS PROPERTY IN SECTION	T. S. R. E. W.	
4. LOT NO. _____, RECORDED PLAT _____		
5. PRIVATE CLAIMS _____		

REGISTER OF DEEDS STAMP AND FILING NUMBER _____

I, KENNETH J. OSTLING, do hereby certify that under requirements of P.A. 74, Michigan P.A. of 1970, the corner points mentioned in lines 1 and 2 above were, in a field survey on SEPTEMBER 22, 1983, established, re-established, monumented, re-monumented, recovered or restored as expressed below and in conformance with regulations and rules therefore as required in the current manual of survey instructions of the United States Department of the Interior, Bureau of Land Management or by a decree of a court of law. Furthermore, that the corner points mentioned in lines 3, 4 and 5 above were, in a field survey on _____, 19____, found, recovered, restored, established or re-established as expressed below and in conformance with the rules of the Michigan State Board of Registration for Land Surveyors or, by a Decree of a Court of law:

A. Description of original monument and accessories and or subsequent restoration:

B. Description of corner evidence found and or method applied in restoring or re-establishing corner:


- B-1 - RESET PRESQUE ISLE COUNTY MONUMENT IN LINE WITH FENCE SOUTH, ON LINE BETWEEN SECTION CORNERS, AFTER CONSULTATION WITH COUNTY SURVEYOR PORTER. IT WAS CONCLUDED THE PIPE FOUND DURING COUNTY REMONUMENTATION PROJECT HAD BEEN SET ERRONEOUSLY AT MIDPOINT ON LINE, AND THAT THE INITIAL POINT OF THE FENCE WAS A BETTER INDICATION OF THE PROPER LOCATION FOR THE CORNER.
- B-3 - SET CORNER AT FENCE CORNER WHICH FALLS WITHIN 30' OF PROPORTIONATE MEASURE, BUT WAS CONSIDERED BEST EVIDENCE OF PROPER LOCATION FOR THIS CORNER.

C. Description of monument for corner and accessories established to perpetuate locating the position of the corner:

	B-1		B-3
PRESQUE ISLE COUNTY MONUMENT			SET DNR MONUMENT
4" W. PINE	S62°E 44.2'		4" BALSAM N45°W 37.1'
16" ASPEN	S67°W 59.1'		6" SPRUCE N16°E 36.0'
FENCE CORNER	S3°W 45.3'		
FENCE CORNER	N49°W 62.1'		

SIGNED BY Kenneth Ostling DATE 2/6/84

SURVEYOR'S MICHIGAN REGISTRATION NO. 10068

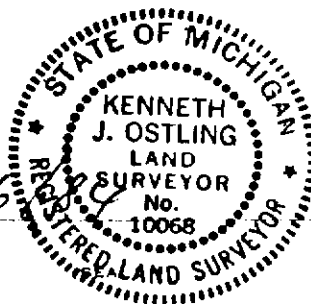

FOR STATE AND UNITED STATES AGENCIES:

SIGNED BY _____ DATE _____

APPROVED AND SIGNED BY _____ DATE _____

CHIEF OF SURVEY PARTY

MICHIGAN REGISTERED LAND SURVEYOR

(SEAL)

SURVEYOR'S MICHIGAN REGISTRATION NO. _____

PRESQUE ISLE COUNTY