LAND CORNER RECORDATION CERTIFICATE

Filing Requirement of Act 74, Mich. P.A. 1970

For corners in PRESQUE ISLE (County)

	Located In:	Corner Code #44
1. Public Land Survey	T 35N R 3E	6-4
	T ___ R ___	
	T ___ R ___	
	T ___ R ___	
2. Property Controlling	S 10 T ___ R ___	10, 12, 14
in Section	S ___ T ___ R ___	
3. Miscellaneous	S ___ T ___ R ___	
Property in Sec.	S ___ T ___ R ___	

Register of Deeds Stamp & File Number

4. Lot No. _____, Recorded Plat _____
5. Private Claims _____

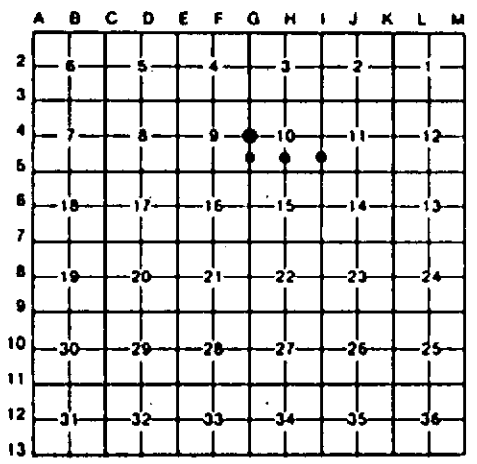

I, CARL F. ROSER, in a field survey on JUNE 7, 19 94, do hereby certify that under requirements of P.A. 74, Michigan P.A. of 1970, the corner points mentioned in lines 1 and 2 above were in conformance with regulations and rules therefore as required in the current manual of survey instructions of the United States Department of the Interior, Bureau of Land Management or by a decree of a Court of Law and/or that the corner points mentioned in lines 3, 4 and 5 above were in conformance with the rules of the Michigan Board of Land Surveyors or by a Decree of a Court of Law; established, re-established, monumented, re-monumented, recovered, found as expressed below:

NOTE: Not more than 4 corners, all in the same town and range, may be recorded on this certificate.

A. Description of original monument and accessories and/or subsequent restoration:

6-4	10	12	14
(NO EVIDENCE OF G.L.O. CORNER, B.T'S, LINE TREES & TOPOGRAPHY, AS CALLED OUT IN THE G.L.O. LINE NOTES; UNLESS NOTED IN ITEM "B" BELOW.)			

STATE OF MICHIGAN
CARL F. ROSER
LAND SURVEYOR
No. 12028
REGISTERED LAND SURVEYOR

B. Description of corner evidence found and/or method applied in restoring or reestablishing corner:

6-4	10	12	14
FD 1/2" ROD AS PREVIOUSLY ESTAB BY RLS AT S.P. POSITION.	ESTAB'D NW CORNER OF S 1/2 OF SW 1/4 OF SEC 10; EQUIDISTANT AND ON LINE BETWEEN RECOVERED W 1/4 COR AND SW COR OF SEC 10.	ESTAB NW COR OF S 1/2 OF SE 1/4 OF SEC 10 PER STD BLM INSTRUCTIONS FOR SEC SUBN'S. TRUE LINE WAS CUT-IN FOR 1/2 MILE TO E & W ALONG SOUTH (E-W) 1/8 LINE OF SAID SEC 10.	ESTAB NE CORNER OF S 1/2 OF SE 1/4 OF SEC 10; PER STD BLM INSTRUCTIONS. E-W SMOOTH WIRE SINGLE STRAND FN IS 182' SOUTH. N-S SMOOTH WIRE SINGLE STRAND FN IS 14.5' EAST. BILL KARSTEN TOLD C.F.ROSER ON 11/10/92 THAT HIS DAD HAD ESTAB FN'S BY APPROX LOCATION ONLY. TRUE LINE WAS CUT-IN WEST 1/2 MILE ALONG NORTH LINE OF S 1/2 OF SE 1/4 OF SEC. 10.

C. Description of monument for corner and accessories established to perpetuate locating the position of the corner:

6-4	10	12	14
FD 1/2" IR ROD W/CAP. BISCHER #22428.	SET 5/8" X 30" REROD W/CAP & RED TOP POST.	SET 5/8" X 34" REROD W/CAP & CED POST W/LOC TAG.	SET 5/8" X 30" REROD W/CAP AND SQUARED TOP CEDAR POST.
#8" BALSAM N35°W 7.03'	#18" JACK PINE S80°E 10.46'	#14" W PINE N14°W 23.84'	#5" MAPLE S87°W 16.10'
8" SPRUCE S27°W 18.62'	# 6" JACK PINE S67°W 14.84'	# 8" W PINE N81°E 15.28'	#7" MAPLE N60°E 6.38'
8" MAPLE S81°W 38.07'	# 6" JACK PINE N74°W 21.01'	# 8" W PINE S09°E 25.11'	#4" MAPLE S25°E 25.01'
C/L TRAIL (N-S) EAST 8.2'	14" DBL J PINE N39°E 17.04'	#20" RED PINE S30°W 14.57'	#8" MAPLE S28°W 20.69'
N-S FN WEST 4.1'		SOUTH 160'± TO SINGLE STRAND SMOOTH WIRE FN E & W.	SET SLOPE STK & LATH ON TRUE LINE W. S86°33'47"W 342.31'
FN COR N & W SOUTH 73.5'			
#OLD NIT BY BISCHER.	#LG NAILS W/BRASS TAGS. UPPER & LOWER BLAZES.	#LG NAILS W/BRASS TAGS.	#LG NAILS AND BRASS TAGS.

Signed by Carl F. Roser Date 6-08-95

Surveyor's Michigan License No. 12028

FORM APPROVED BY MICHIGAN STATE BOARD OF LAND SURVEYORS, JAN. 28, 1971
REVISED MAY 14, 1975
REVISED JAN., 1983