LAND CORNER RECORDATION CERTIFICATE

Filing Requirement of Act 74, Mich. P.A. 1970

For corners in PRESQUE ISLE (County)

	Located in:	Corner Code #*
1. Public Land Survey	T 35N R 3E	F-3, G-3,
	T ___ R ___	H-3
	T ___ R ___	
	T ___ R ___	
2. Property Controlling	S ___ T ___ R ___	
in Section	S ___ T ___ R ___	
3. Miscellaneous	S ___ T ___ R ___	
Property in Sec.	S ___ T ___ R ___	

Register of Deeds Stamp & File Number

4. Lot No. _____ , Recorded Plat _____
5. Private Claims _____

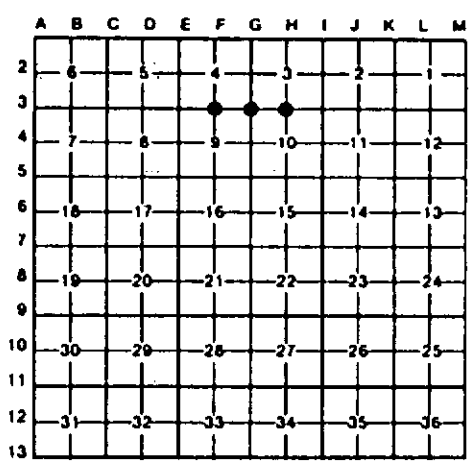

I, CARL F. ROSER, in a field survey on JUNE 7, 19 94, do hereby certify that under requirements of P.A. 74, Michigan P.A. of 1970, the corner points mentioned in lines 1 and 2 above were in conformance with regulations and rules therefore as required in the current manual of survey instructions of the United States Department of the Interior, Bureau of Land Management or by a decree of a Court of Law and/or that the corner points mentioned in lines 3, 4 and 5 above were in conformance with the rules of the Michigan Board of Land Surveyors or by a Decree of a Court of Law; established, re-established, monumented, re-monumented, recovered, found as expressed below:

NOTE: Not more than 4 corners, all in the same town and range, may be recorded on this certificate.

A. Description of original monument and accessories and/or subsequent restoration:

F-3 G-3 H-3

(NO EVIDENCE OF G.L.O. CORNER, B.T'S, LINE TREES & TOPOGRAPHY, AS CALLED OUT IN THE G.L.O. LINE NOTES; UNLESS NOTED IN ITEM "B" BELOW.)

B. Description of corner evidence found and/or method applied in restoring or reestablishing corner:

F-3
FD 1/2" ROD; FITS CLOSE TO S.P. POSITION AS NOTED ON PORTER'S SEC. 9 WORK SHEET.

G-3
FD 1/2" PIPE FOR NW COR OF SEC 10; AS PREVIOUSLY RECOVERED (PORTER FD 1/2" PIPE, BURIED 6" DEEP) AND WIT BY RLS DEL PORTER.

H-3
ACCEPTED STRAIGHT (VERTICAL) POSITION OF BELOW-NOTED FD 1/2" ROD FOR N 1/4 COR OF SEC 10. COR PREVIOUSLY SET & WIT. BY P.S. DEL PORTER, MIDWAY BETWEEN SEC COR'S TO E & W AND IN APPROX CTR OF E-W CO RD.

C. Description of monument for corner and accessories established to perpetuate locating the position of the corner:

F-3
FD 1/2" IRON ROD (NO CAP). (PLACED LG NAILS & BRASS TAGS ON WITS.)

5" CEDAR	S01°W	38.94'
# 7" ELM	N39°W	44.35'
##10" W BIRCH	N07°W	61.21'
##8" W BIRCH	N29°E	66.38'
C/L CO RD	SOUTH	8.0'±

#=OLD WIT BY RLS D.PORTER.
#=SLOPE DISTANCE.

G-3
FD 1/2" IR PIPE IN RD INTERSEC (E-W-N), 6-8" BELOW-GRADE. LG NAILS & BRASS TAGS ON WITS.

UTILITY POLE	N24°W	64.54'
#FN COR POST	N43°E	48.66'
3" ELM	S64°W	40.72'
C/L E-W(POMERANKE)RD	NORTH	2'±
C/L RD. N(BERGE)	EAST	3'±

#DEL PORTER #15410 WIT.

H-3
FD 1/2" IR ROD BENT N & W; REPL'D W/ 5/8" REROD W/PS CAP. PLACED LG NAILS & BRASS TAGS ON WITS.

#10" APPLE	N56°E	43.04'
#10" ASH	N69°W	97.71'
FN POST	S06°E	32.04'
#C/L E-W ROAD	NORTH	1.0'±

#OLD PORTER #15410 WIT.

STATE OF MICHIGAN
CARL F. ROSER
LAND SURVEYOR
No. 12028
REGISTERED LAND SURVEYOR

Signed by Carl F. Roser Date 6-08-95

Surveyor's Michigan License No. 12028

FORM APPROVED BY MICHIGAN STATE BOARD OF LAND SURVEYORS, JAN. 28, 1971
REVISED MAY 14, 1975
REVISED JAN., 1983