LAND CORNER RECORDATION CERTIFICATE

Filing Requirement of Act 74, Mich. P.A. 1970

For corners in PRESQUE ISLE (County)

	Located In:	Corner Code ##
1. Public Land Survey	T 35N R 3E	6-6, 6-7
	T ___ R ___	H-7
	T ___ R ___	
	T ___ R ___	
2. Property Controlling	S 21 T ___ R ___	7
in Section	S ___ T ___ R ___	
3. Miscellaneous	S ___ T ___ R ___	
Property in Sec.	S ___ T ___ R ___	

Register of Deeds Stamp & File Number

4. Lot No. _____ , Recorded Plat _____
5. Private Claims _____

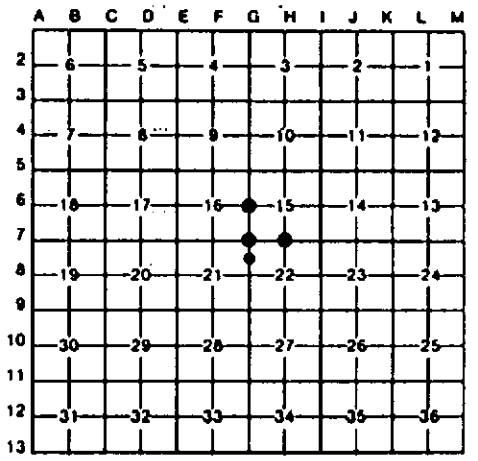

I, CARL F. ROSER, in a field survey on MARCH 18, 19 94, do hereby certify that under requirements of P.A. 74, Michigan P.A. of 1970, the corner points mentioned in lines 1 and 2 above were in conformance with regulations and rules therefore as required in the current manual of survey instructions of the United States Department of the Interior, Bureau of Land Management or by a decree of a Court of Law and/or that the corner points mentioned in lines 3, 4 and 5 above were in conformance with the rules of the Michigan Board of Land Surveyors or by a Decree of a Court of Law; established, re-established, monumented, re-monumented, recovered, found as expressed below:

NOTE: Not more than 4 corners, all in the same town and range, may be recorded on this certificate.

A. Description of original monument and accessories and/or subsequent restoration:

6-6 6-7 H-7 7

(NO EVIDENCE OF G.L.O. CORNER, B.T'S, LINE TREES & TOPOGRAPHY, AS CALLED OUT IN THE G.L.O. LINE NOTES; UNLESS NOTED IN ITEM "B" BELOW.)

STATE OF MICHIGAN
CARL F. ROSER
LAND SURVEYOR
No. 12028
REGISTERED LAND SURVEYOR

B. Description of corner evidence found and/or method applied in restoring or reestablishing corner:

6-6	6-7	H-7	7
FD PRESQUE ISLE COUNTY MON FOR W 1/4 COR OF SEC 15. FITS CLOSE TO S.P. POSITION BETWEEN FD SEC COR'S TO N & S.	FD PRESQUE ISLE CO MON IN RD INTERSEC N-S-E-W; FOR SW COR OF SEC 15.	FD PRESQUE ISLE CO MON FOR S 1/4 COR OF SEC 15. CTR OF E-W ROAD IS 3.5' SOUTH.	DROVE 5/8" X 34" REROD FOR SE CORNER OF N 1/2 OF NE 1/4 OF SEC 21 PER STANDARD BLM INSTRUCTIONS. CTR OF N-S ROAD IS 1.6' EAST.

C. Description of monument for corner and accessories established to perpetuate locating the position of the corner:

6-6	6-7	H-7	7
FD PRESQUE ISLE COUNTY MON.	FD PRESQUE ISLE CO MON. LG NAILS W/BRASS TAGS & BLAZES ON WITS.	FD PRESQUE ISLE COUNTY MON. LG NAILS, BRASS TAGS & BLAZES ON WIT.	DR 5/8" X 34" REROD W/C.F. ROSER CAP #12028, 4" BELOW RD. LG NAILS W/BRASS TAGS ON WITS.
#16" J PINE N81°E 12.79'	#22" J PINE N75°E 45.69'	#12" J PINE N58°W 21.92'	
#12" J PINE S32°E 22.29'	#12" J PINE S24°E 25.06'	6" R PINE N35°W 33.75'	4" R PINE S78°W 32.56'
#14" R PINE N89°W 33.31'	#22" DBL J PINE N64°W 55.03'	SET RED TOP	7" MAPLE N52°E 32.90'
5" R PINE N32°W 35.46'	10" W PINE S42°W 63.70'	CED POST NORTH 4.5'	8" R PINE S80°E 53.65'
SET RED TOP CED POST		3" J PINE N64°E 24.26'	6" MAPLE S20°E 31.26'
W/LOC TAG EAST 6.0'		3" MAPLE SOUTH 7.79'	SET RED TOP CED POST W/
C/L N-S ROAD WEST 6.0'			LOC TAG N82°E 11.8'
#OLD WITNESSES BY OTHERS.	#OLD WITS BY OTHERS.	#=OLD WIT BY OTHERS.	

Signed by Carl F. Roser Date 6-08-95

Surveyor's Michigan License No. 12028

FORM APPROVED BY MICHIGAN STATE BOARD OF LAND SURVEYORS, JAN. 20, 1971
REVISED MAY 14, 1975
REVISED JAN., 1983