LAND CORNER RECORDATION CERTIFICATE

Filing Requirement of Act 74, Mich. P.A. 1970

For corners in PRESQUE ISLE (County)

	Located In:	Corner Code #t
1. Public Land Survey	T 35N R 3E	J-7, K-7
	T ____ R ____	K-8, K-9
	T ____ R ____	
	T ____ R ____	
2. Property Controlling	S ____ T ____ R ____	
in Section	S ____ T ____ R ____	
3. Miscellaneous	S ____ T ____ R ____	
Property in Sec.	S ____ T ____ R ____	

Register of Deeds Stamp & File Number

4. Lot No. _____ , Recorded Plat _____
5. Private Claims _____

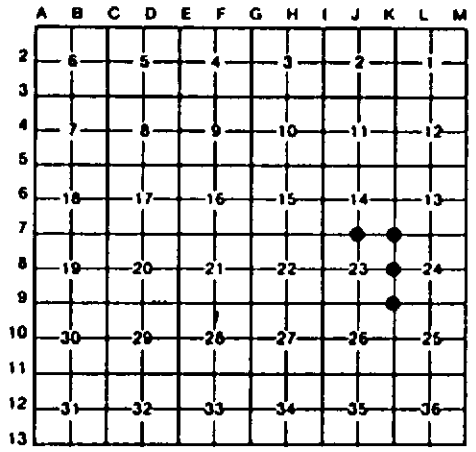

I, CARL F. ROSER, in a field survey on JUNE 7, 19 94, do hereby certify that under requirements of P.A. 74, Michigan P.A. of 1970, the corner points mentioned in lines 1 and 2 above were in conformance with regulations and rules therefore as required in the current manual of survey instructions of the United States Department of the Interior, Bureau of Land Management or by a decree of a Court of Law and/or that the corner points mentioned in lines 3, 4 and 5 above were in conformance with the rules of the Michigan Board of Land Surveyors or by a Decree of a Court of Law; established, re-established, monumented, re-monumented, recovered, found as expressed below:

NOTE: Not more than 4 corners, all in the same town and range, may be recorded on this certificate.

A. Description of original monument and accessories and/or subsequent restoration:

J-7 K-7 K-8 K-9

(NO EVIDENCE OF G.L.O. CORNER, B.T'S, LINE TREES & TOPOGRAPHY, AS CALLED OUT IN THE G.L.O. LINE NOTES; UNLESS NOTED IN ITEM "B" BELOW.)

STATE OF MICHIGAN
CARL F. ROSER
LAND SURVEYOR
No. 12028
REGISTERED LAND SURVEYOR

B. Description of corner evidence found and/or method applied in restoring or reestablishing corner:

J-7
SET DNR MON FOR S 1/4 COR OF SEC 14; MIDWAY & ON LINE BETW SEC CORS TO E & W. COR FALLS IN E-W TRAIL ROAD, THE CTR OF WHICH IS 4' SOUTH.

K-7
FD PRESQUE ISLE COUNTY MON FOR SE COR OF SEC 14. CORNER FALLS IN INTERSEC OF TRAIL ROADS E-W-N. FITS ONE RON BISCHER WIT.

K-8
FD 1/2" IR ROD W/DEL PORTER CAP #15410 FOR E 1/4 CORNER SEC 23. FITS S.P. POSITION.

CORNER FALLS IN W'LY EDGE OF ALDER SWAMP.

K-9
FD PRESQUE ISLE COUNTY MON FOR SE COR SEC 23.

C. Description of monument for corner and accessories established to perpetuate locating the position of the corner:

J-7
SET DNR MON, BURIED 6". LG NAILS W/BRASS TAGS & BLAZES ON WITS.

14" R PINE	N51°W	17.77'
12" R PINE	N19°E	21.28'
8" R PINE	N76°E	21.78'
4" OAK	S01°E	14.63'
10" J PINE	S30°W	26.46'
SET CED POST	NORTH	6.01'

K-7
FD PRESQUE ISLE CO MON.

#12" J PINE	N20°E	40.16'
3" R PINE	N66°E	26.14'
4" R PINE	N76°E	51.29'
J PINE STP (CLUMP OF 3)	S65°W	28.61'

CLEARCUT SE,SW & NW QUADRANTS.

#P.S.22428 CAP ON NAIL AS WIT.

K-8
FD 1/2" IRON ROD AND CED POST. LG NAILS W/BRASS TAGS ON WITS.

#7" SPRUCE	N28°W	7.51'
6" MAPLE	S69°W	19.31'
7" SPRUCE	S36°W	37.23'
#8" NORWAY PINE	N21°E	45.15'
##16" OAK	N31°W	32.8'

#(SLOPE DISTANCE)
#OLD WITNESSES BY OTHERS.

K-9
FD PRESQUE ISLE CO MON. LG NAILS W/BRASS TAGS & BLAZES ON WITS.

4"CONC HWY ROW MON SOUTH		23.29
14" NORWAY PINE	S13°W	34.61
8" NORWAY PINE	S78°W	27.04
6" NORWAY PINE	S78°E	23.64
14" NORWAY PINE	S22°E	37.88
C/L M-68 ST HWY	NORTH	51.5'

Signed by Carl F. Roser Date 6-08-95

Surveyor's Michigan License No. 12028

FORM APPROVED BY MICHIGAN STATE BOARD OF LAND SURVEYORS, JAN. 28, 1971
REVISED MAY 14, 1975
REVISED JAN., 1983