

MICHIGAN
DEPARTMENT OF CONSERVATION
FORESTRY DIVISION

LAND CORNER RECORD

T. 35 N.R. 4 E


Presque Isle COUNTY

DESCRIPTION OF CORNER 1/4 corner common to Sections 1 and 2

CORNER MONUMENT 1" pipe with 4" brass cap

DATE MONUMENT PLACED AND WITNESSED February 22, 1960

WITNESSES TO CORNER.....

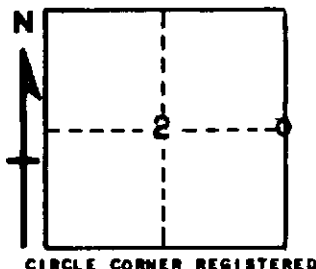

4" Maple - N14W - 25.0 feet

3" B. Ash - S69W - 14.2 feet

AND

DESCRIPTION IN DETAIL AS TO HOW CORNER WAS LOCATED AND IDENTIFIED OR RESTORED.

This corner was established by proportionate measurement between section corners by Forestry Division survey crew while making a survey in this area. Unable to identify government BTs.

SURVEYOR'S SEAL

SIGNED *Kenneth J. Ostberg* DATE 2-24-61
REGISTERED LAND SURVEYOR