

3657

FEB 12 2001

LIGER 340 PAGE 347

2000 PRESQUE ISLE COUNTY REMONUMENTATION

SECTION

LAND CORNER RECORDATION CERTIFICATE  
Filing Requirement of Act 74, Mich. P.A. 1970

For corners in

Presque Isle  
(County)

Located In:

Corner Code #

1. Public Land Survey

T35N R2E H-3

T      R     

T      R     

T      R     

2. Property Controlling in Section

S      T      R     

S      T      R     

3. Miscellaneous Property in Sec.

S      T      R     

S      T      R     

PRESQUE ISLE COUNTY  
RECORDED

2000 DEC 11 AM 9:52


*Jane M. Jamt*  
REGISTER OF DEEDS

Register of Deeds Stamp & File Number

4. Lot No. \_\_\_\_\_, Recorded Plat \_\_\_\_\_  
5. Private Claims \_\_\_\_\_

I, Ronald Bischer, in a field survey on 10/26/0019 do hereby state that under requirements of P.A. 74, Michigan P.A. of 1970, the corner points mentioned in lines 1 and 2 above were in conformance with regulations and rules therefore as required in the current manual of survey instructions of the United States Department of the Interior, Bureau of Land Management or by a decree of a Court of Law and /or that the corner points mentioned in lines 3, 4 and 5 above were in conformance with the rules of the Michigan Board of Land Surveyors or by a Decree of a Court of Law; established, re-established, monumented, recovered, found as expressed below:

NOTE: Not more than 2 corners, all in the same town and range, may be recorded on this certificate.

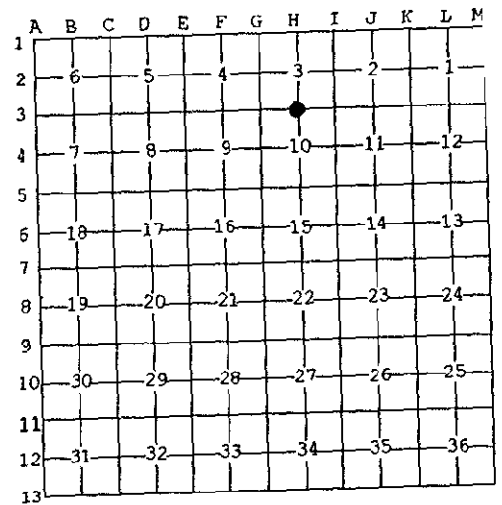


A. Description of original monument and accessories and/or subsequent restoration:

Aug. 1855 George Cannon set wood post and 2 witnesses  
Oct. 1997 Ronald Bischer #22428 found 2 stake points and both original stumps in place set 1/2" rod recorded distances from OBTs left 4 witnesses

B. Description of corner evidence found and/or method applied in restoring or reestablishing corner:

found 2 stake points old original witnesses and 1/2" rod and cap #22428 and 4 new witnesses from 1997

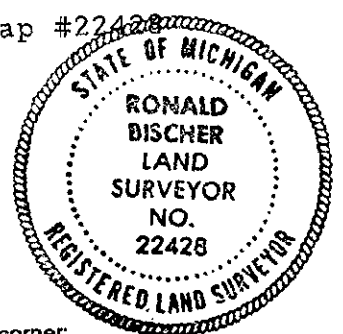

C. Description of monument for corner and accessories established to perpetuate locating the position of the corner:

Oct. 26, 2000  
1/2" rod and cap #22428

S80° E 17.44' 10" Cedar  
S43° W 10.92' 13" Cedar  
N41° W 12.81' 12" Cedar  
N31° E 13.80' 8" Spruce  
Both OBTs in place

Ratified by Peer Group  
in accordance with P.A. 345  
Chairman *Norman J. Orsini*  
Date 12-11-00

Signed by Ronald E. Bischer  
Surveyor's Michigan License No. 22428

Date 11-7-2000