

FEB 12 2001

YEAR 2000 PRESQUE ISLE COUNTY, STATE OF MICHIGAN REMONUMENTATION

SECTION

LAND CORNER RECORDATION CERTIFICATE
Filing Requirement of Act 74, Mich. P.A. 1970

For corners in
PRESQUE ISLE
(County)

Located In:

Corner Code #

- 1. Public Land Survey T 35N R 2E H7
T 35N R 2E H9
T R
T R
2. Property Controlling in Section S T R
S T R
3. Miscellaneous Property in Sec. S T R
S T R


PRESQUE ISLE COUNTY
RECORDED

2000 DEC 11 AM 9:46

Janet M. Jant

REGISTER OF DEEDS
Register of Deeds Stamp & File Number

- 4. Lot No. Recorded Plat
5. Private Claims

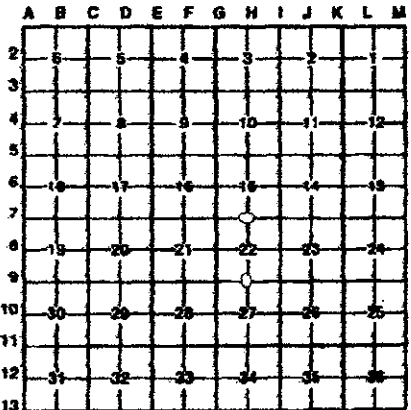

James A. Beck in a field survey on Sep 24, Oct 19, 2000
do hereby certify that under requirements of P.A. 74, Michigan P.A. of 1970, the corner points mentioned in lines 1 and 2 above were in conformance with regulations and rules therefore as required in the current manual of survey instructions of the United States Department of the Interior, Bureau of Land Management or by a decree of a Court of Law and/or that the corner points mentioned in lines 3, 4 and 5 above were in conformance with the rules of the Michigan Board of Land Surveyors or by a Decree of a Court of Law; established, re-established, monumented, re-monumented, recovered, found as expressed below:

NOTE: Not more than 4 corners, all in the same town and range, may be recorded on this certificate.

A. Description of original monument and accessories and/or subsequent restoration:

- H 7 September 26, 1978 P.A. 74 Certificate by Delmer Porter P.S. 15410
1" pipe in monument box
N38°W 89.30' 15" Oak
N67°E 99.77' 10" Oak
S43°W 84.10' 12" Oak
H 9 January 5, 1981 P.A. 74 Certificate by Ronald Biecher 22428
T iron
Due West 149.75' 8" Apple
S87°E 92.37' 4" apple
S12°E 110.98', 6" Apple

B. Description of corner evidence found and/or method applied in restoring or reestablishing corner:

- H 7 found P.K. nail
N45°W 89.80' # 5778 Dean.C. DeLaMater tag in-grown in 28" Oak
N67°E 99.77' , #5778 (Dean C. DeLaMater) tag in 13" Oak
South 33.00' T iron
H 9 found "T" iron with # 5778 DeLaMater cap
West 149.75' 10" Apple
S87°E 92.37' 6" Apple with root blaze
S12°E 110.98' 6" Apple (multi stem)

Ratified by Peer Group in accordance with P.A. 345


Chairman Norman J. Quain

Date 12-11-00

C. Description of monument for corner and accessories established to perpetuate locating the position of the corner:

- H 7 1/2" iron rod & P.S. 21559 cap
N45°W 89.80' # 5778 Dean.C. DeLaMater tag in-grown in 28" Oak, set P.S. 21559 tag below at N45°W 89.78'
N67°E 99.77' , #5778 (Dean C. DeLaMater) tag in 13" Oak
S 5°E 33.92' P.S. 21559 tag in power pole
South 33.00' T iron
H 9 "T" iron with # 5778 DeLaMater cap encircled "T" iron with large rocks
West 149.75' 10" Apple
S87°E 92.37' 6" Apple with root blaze
S12°E 110.98' 6" Apple (multi stem)
S60° E + or -, 35.4' set P.K. nail in top most rock of pile corner falls in open area to North and West of group of Apple trees

Signed by James A. Beck P.S. 21559
Surveyor's Michigan License No.

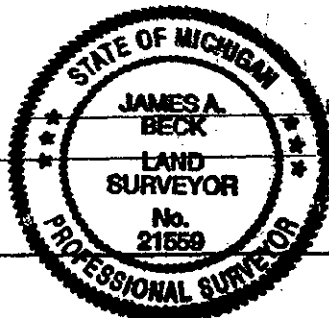

Date Nov. 8, 2000