

FEB 12 2001

LIBER 340 PAGE 345

2000 PRESQUE ISLE COUNTY REMONUMENTATION

SECTION

LAND CORNER RECORDATION CERTIFICATE
Filing Requirement of Act 74, Mich. P.A. 1970

For corners in

Presque Isle (County)	Located in:	Corner Code #
1. Public Land Survey	T35NR 2E	I-2
	T R	
	T R	
	T R	
2. Property Controlling in Section	S T R	
	S T R	
3. Miscellaneous Property in Sec.	S T R	
	S T R	

PRESQUE ISLE COUNTY
RECORDED

2000 DEC 11 AM 9:52

Just M. Jamb
REGISTER OF DEEDS

Register of Deeds Stamp & File Number

4. Lot No. _____, Recorded Plat _____
5. Private Claims _____


I, Ronald Bischer, in a field survey on 10/26/2000 do hereby state that under requirements of P.A. 74, Michigan P.A. of 1970, the corner points mentioned in lines 1 and 2 above were in conformance with regulations and rules therefore as required in the current manual of survey instructions of the United States Department of the Interior, Bureau of Land Management or by a decree of a Court of Law and/or that the corner points mentioned in lines 3, 4 and 5 above were in conformance with the rules of the Michigan Board of Land Surveyors or by a Decree of a Court of Law; established, re-established, monumented, recovered, found as expressed below.

NOTE: Not more than 2 corners, all in the same town and range, may be recorded on this certificate.

1	A	B	C	D	E	F	G	H	I	J	K	L	M
2		6		5		4		3	●	2		1	
3													
4		7		8		9		10		11		12	
5													
6		18		17		16		15		14		13	
7													
8		19		20		21		22		23		24	
9													
10		30		29		28		27		26		25	
11													
12		31		32		33		34		35		36	
13													

A. Description of original monument and accessories and/or subsequent restoration:

Aug. 1855 George Cannon set wood post and 2 witnesses
Oct. 1997 Ronald Bischer set 1/2" rod and cap #22428 by single Proportion left 4 witnesses

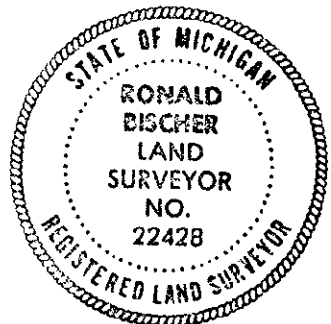

B. Description of corner evidence found and/or method applied in restoring or reestablishing corner:

found 1/2" rod and cap #22428 and 4 witnesses

C. Description of monument for corner and accessories established to perpetuate locating the position of the corner:

Oct. 26, 2000
1/2" rod and cap #22428

S77° E	15.46'	16" Norway	O.W.
S10° E	30.57'	11" Norway	O.W.
S65° E	32.06'	10" Norway	O.W.
N27° E	21.34'	9" Norway	O.W.

Ratified by Peer Group
in accordance with P.A. 345
Chairman *Norman J. ...*
Date 12-11-00

Signed by *Ronald R. Bischer*
Surveyor's Michigan License No. 22428

Date 11-7-2000