

FEB 12 2001

2000 PRESQUE ISLE COUNTY REMONUMENTATION

SECTION

LAND CORNER RECORDATION CERTIFICATE
Filing Requirement of Act 74, Mich. P.A. 1970

For corners in

<u>Presque Isle</u> (County)	Located In:	Corner Code #
1. Public Land Survey	T <u>35NR2E</u>	I-4
	T ___ R ___	_____
	T ___ R ___	_____
	T ___ R ___	_____
2. Property Controlling in Section	S ___ T ___ R ___	_____
	S ___ T ___ R ___	_____
3. Miscellaneous Property in Sec.	S ___ T ___ R ___	_____
	S ___ T ___ R ___	_____

PRESQUE ISLE COUNTY
RECORDED

2000 DEC 11 AM 9:53

Just M. Jamb
REGISTER OF DEEDS

Register of Deeds Stamp & File Number

4. Lot No. _____, Recorded Plat _____
5. Private Claims _____

I, Ronald Bischer, in a field survey on 10/26/00 do hereby state that under requirements of P.A. 74, Michigan P.A. of 1970, the corner points mentioned in lines 1 and 2 above were in conformance with regulations and rules therefore as required in the current manual of survey instructions of the United States Department of the Interior, Bureau of Land Management or by a decree of a Court of Law and/or that the corner points mentioned in lines 3, 4 and 5 above were in conformance with the rules of the Michigan Board of Land Surveyors or by a Decree of a Court of Law; established, re-established, monumented, recovered, found as expressed below:

NOTE: Not more than 2 corners, all in the same town and range, may be recorded on this certificate.


A	B	C	D	E	F	G	H	I	J	K	L	M
2	6	5	4	3	2	1						
4	7	8	9	10	11	12						
6	18	17	16	15	14	13						
8	19	20	21	22	23	24						
10	30	29	28	27	26	25						
12	31	32	33	34	35	36						

A. Description of original monument and accessories and/or subsequent restoration:

Aug. 1855 George Cannon set wood post and 2 witnesses
1934+- Marcus Schaaf #3104 set 1 1/2" pipe in conc built fire lane north and south
Nov. 1978 Delmer Porter #15410 found 1 1/2" pipe replaced with remon mon
left 3 new witnesses

B. Description of corner evidence found and/or method applied in restoring or reestablishing corner:

Found Remon mon 1 original witness and 3 Porter witnesses

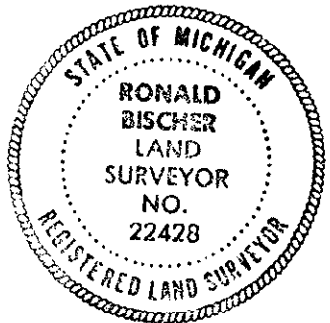

C. Description of monument for corner and accessories established to perpetuate locating the position of the corner:

Oct. 26, 2000
Remon Mon

S29°W 42.60' 31" White Pine O.W.
S42°W 22.83' 8" Twin Maple O.W.
S75°E 25.68' 8" Maple O.W.
N26°E 49.70' 5" White Pine
White Pine OBT stump still in place

Ratified by Peer Group
in accordance with P.A. 345

Chairman *Norman J. Davis*
Date 12-11-00

Signed by Ronald R. Bischer
Surveyor's Michigan License No. 22428

Date 11-7-2000