

3660

FEB 12 2001

2000 PRESQUE ISLE COUNTY REMONUMENTATION

SECTION

LAND CORNER RECORDATION CERTIFICATE  
Filing Requirement of Act 74, Mich. P.A. 1970

For corners in

<u>Presque Isle</u> (County)	Located In:	Corner Code #
1. Public Land Survey	T35NR 2E	I-5
	T___ R___	_____
	T___ R___	_____
	T___ R___	_____
2. Property Controlling in Section	S___ T___ R___	_____
	S___ T___ R___	_____
3. Miscellaneous Property in Sec.	S___ T___ R___	_____
	S___ T___ R___	_____

PRESQUE ISLE COUNTY  
RECORDED

2000 DEC 11 AM 9:53

*June M. Jamit*  
REGISTER OF DEEDS

Register of Deeds Stamp & File Number

4. Lot No. \_\_\_\_\_, Recorded Plat \_\_\_\_\_  
5. Private Claims \_\_\_\_\_

I, Ronald Bischer, in a field survey on 10/26/00 do hereby state that under requirements of P.A. 74, Michigan P.A. of 1970, the corner points mentioned in lines 1 and 2 above were in conformance with regulations and rules therefore as required in the current manual of survey instructions of the United States Department of the Interior, Bureau of Land Management or by a decree of a Court of Law and /or that the corner points mentioned in lines 3, 4 and 5 above were in conformance with the rules of the Michigan Board of Land Surveyors or by a Decree of a Court of Law; established, re-established, monumented, recovered, found as expressed below:

NOTE: Not more than 2 corners, all in the same town and range, may be recorded on this certificate.


	A	B	C	D	E	F	G	H	I	J	K	L	I
1													
2	6		5		4		3		2		1		
3													
4	7		8		9		10		11		12		
5									●				
6	18		17		16		15		14		13		
7													
8	19		20		21		22		23		24		
9													
10	30		29		28		27		26		25		
11													
12	31		32		33		34		35		36		
13													

A. Description of original monument and accessories and/or subsequent restoration:

Aug. 1855 George Cannon set wood post and 2 witnesses  
1934+- Marcus Schaaf #3104 set 4x4 scribed cedar post  
1969 Delmer Porter #15410 found 4x4 cedar post set conc. mon & 3 witnesses  
May 1973 Delmer Porter #15410 found conc mon & 3 witnesses

B. Description of corner evidence found and/or method applied in restoring or reestablishing corner:

found conc mon and 3 witnesses from porter  
found both OBTS with good scribe marks

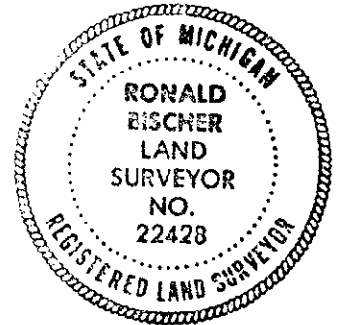

C. Description of monument for corner and accessories established to perpetuate locating the position of the corner:

Oct. 26, 2000  
Conc mon cap #22428

N55°E 10.30' 16" Cedar O.W.  
S57°E 12.24' 6" Cedar O.W.  
S03°E 7.80' 6" Cedar O.W.  
N75°W 24.64' 6" Cedar  
Both OBTS in place with good scribe marks

Ratified by Peer Group  
in accordance with P.A. 345

Chairman *Norman J. Quinn*  
Date 12-11-00

Signed by Ronald R. Bischer  
Surveyor's Michigan License No. 22428

Date 11-7-2000