

FEB 12 2001

LIBER 340 PAGE 336

YEAR 2000 PRESQUE ISLE COUNTY, STATE OF MICHIGAN REMONUMENTATION SECTION

LAND CORNER RECORDATION CERTIFICATE
Filing Requirement of Act 74, Mich. P.A. 1970

For corners in
PRESQUE ISLE
(County)

Located In:

Corner Code #

- 1. Public Land Survey T 35N R 2E 16
T 35N R 2E 17
2. Property Controlling S T R
3. Miscellaneous S T R
Property in Sec. S T R


PRESQUE ISLE COUNTY
RECORDED

2000 DEC 11 AM 9:46

Janet M. Jamo
REGISTER OF DEEDS

Register of Deeds Stamp & File Number

- 4. Lot No. , Recorded Plat
5. Private Claims

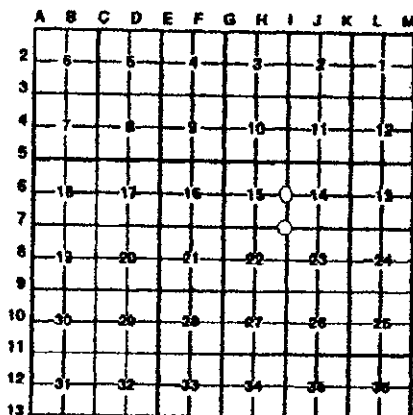

I, James A. Beck, in a field survey on Sep 28 & Sep 29, 2000, do hereby certify that under requirements of P.A. 74, Michigan P.A. of 1970, the corner points mentioned in lines 1 and 2 above were in conformance with regulations and rules therefore as required in the current manual of survey instructions of the United States Department of the Interior, Bureau of Land Management or by a decree of a Court of Law and/or that the corner points mentioned in lines 3, 4 and 5 above were in conformance with the rules of the Michigan Board of Land Surveyors or by a Decree of a Court of Law; established, re-established, monumented, re-monumented, recovered, found as expressed below:

NOTE: Not more than 4 corners, all in the same town and range, may be recorded on this certificate.

A. Description of original monument and accessories and/or subsequent restoration:

- 16 November 11, 1997 P.A. 74 (Land Corner Recordation Certificate) by Ronald Blacher P.S. 22428
17 July 5, 1973 P.A. 74 Recordation by Delmer Porter P.S. 15410
6" Balsam N55°W 62.87'
10' W. Pine S28°W 43.63'
18' N. Pine S64° 121.78.
Mar. 17, 1975 P.A. 132 by Delmer Porter Recorded L208, P648
set 1/2" rod from Delemeters witnesses
N55°W 62.87' 6" Balsam
S64°E 121.78' 18' N. Pine
S28°W 43.63' 10' N. Pine

B. Description of corner evidence found and/or method applied in restoring or reestablishing corner:

- 16 found 1/2" iron and 22428 cap remnants of above original bearing tree stumps visible
17 found 1/2" iron rod in monument box & 2 old witnesses:
S64°E 121.78' 20' Norway Pine (old tag grown over)
S28°W 43.63' 10' Norway Pine

Ratified by Peer Group
in accordance with P.A. 345
Chairman Abraham J. Charis
Date 12-11-00

C. Description of monument for corner and accessories established to perpetuate locating the position of the corner:

- 16 1/2" iron and 22428 cap remnants of above original bearing tree stumps visible
Witnesses:
N84°W 47.90' P.S. 22428 tag in 20' Norway Pine
S23°W 8.05' P.S. 22428 tag in 22' White Pine
N44°W 33.23' P.S. 22428 tag in 22' Norway Pine
S59°W 62.87' P.S. 22428 tag in 24' White Pine
N20°W 17.91' P.S. 21559 tag in 5' Maple
N66°E 22.47' P.S. 21559 tag in 5' Maple
17 1/2" iron rod & P.S. 21559 cap in monument box
Witnesses:
S64°E 121.78' P.S. 21559 tag in 20' Norway Pine
S28°W 43.63' 10' P.S. 21559 tag in 10' Norway Pine
N27°W 45.60' P.S. 21559 tag in 14' White Pine
N56°E 61.85' P.S. 21559 tag in 6' Oak

Signed by James A. Beck P.S. 21559
Surveyor's Michigan License No.

Date Nov. 7, 2000

