

FEB 12 2001

LIBER 340 PAGE 351

LAND CORNER RECORDATION CERTIFICATE
Filing Requirement of Act 74, Mich. P.A. 1970

SECTION

For corners in

Presque Isle
(County)

Located In:

Corner Code #

- 1. Public Land Survey T 35N 2E J-5
 T ___ R ___ _____
 T ___ R ___ _____
 T ___ R ___ _____
- 2. Property Controlling S ___ T ___ R ___
 in Section S ___ T ___ R ___ _____
- 3. Miscellaneous S ___ T ___ R ___
 Property in Sec. S ___ T ___ R ___ _____

PRESQUE ISLE COUNTY
RECORDED

2000 DEC 11 AM 9:53

Gene M. Jamt
REGISTER OF DEEDS

Register of Deeds Stamp & File Number

- 4. Lot No. _____, Recorded Plat _____
- 5. Private Claims _____


I, Ronald Bischer, in a field survey on 10/26/00 do hereby state that under requirements of P.A. 74, Michigan P.A. of 1970, the corner points mentioned in lines 1 and 2 above were in conformance with regulations and rules therefore as required in the current manual of survey instructions of the United States Department of the Interior, Bureau of Land Management or by a decree of a Court of Law and /or that the corner points mentioned in lines 3, 4 and 5 above were in conformance with the rules of the Michigan Board of Land Surveyors or by a Decree of a Court of Law; established, re-established, monumented, recovered, found as expressed below:

NOTE: Not more than 2 corners, all in the same town and range, may be recorded on this certificate.

| | | | | | | | | | | | | | |
|----|---|----|---|----|---|----|---|----|---|----|---|----|---|
| | A | B | C | D | E | F | G | H | I | J | K | L | M |
| 1 | | | | | | | | | | | | | |
| 2 | | 6 | | 5 | | 4 | | 3 | | 2 | | 1 | |
| 3 | | | | | | | | | | | | | |
| 4 | | 7 | | 8 | | 9 | | 10 | | 11 | | 12 | |
| 5 | | | | | | | | | | ● | | | |
| 6 | | 18 | | 17 | | 16 | | 15 | | 14 | | 13 | |
| 7 | | | | | | | | | | | | | |
| 8 | | 19 | | 20 | | 21 | | 22 | | 23 | | 24 | |
| 9 | | | | | | | | | | | | | |
| 10 | | 30 | | 29 | | 28 | | 27 | | 26 | | 25 | |
| 11 | | | | | | | | | | | | | |
| 12 | | 31 | | 32 | | 33 | | 34 | | 35 | | 36 | |
| 13 | | | | | | | | | | | | | |

A. Description of original monument and accessories and/or subsequent restoration:

- Aug. 1855 George Cannon set wood post and 2 witnesses
- 1969 Delmer Porter #15410 set conc. mon by single proportion
- Nov. 1997 Ronald Bischer #22428 found conc mon left 4 witnesses

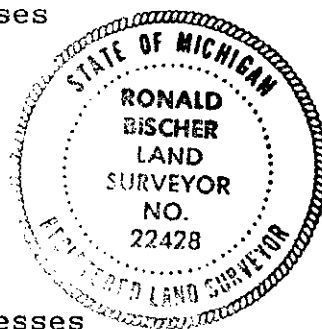

B. Description of corner evidence found and/or method applied in restoring or reestablishing corner:

found conc. mon placed cap #22428 on top found four old witnesses

C. Description of monument for corner and accessories established to perpetuate locating the position of the corner:

Oct, 24, 2000
conc. mon cap #22428

- N84°W 7.65' 4" Fir O.W.
- N21°W 7.37' 6" Fir O.W.
- N72°E 8.54' 5" Aspen O.W.
- S18°E 17.51' 6" Fir o.w.

Ratified by Peer Group
in accordance with P.A. 345

Chairman *Norman J. Quinn*
Date 12-11-00

Signed by *Ronald R. Bischer*
Surveyor's Michigan License No. 22428

Date 11-7-2000