

2000 PRESQUE ISLE COUNTY REMONUMENTATION

FEB 12 2001

LAND CORNER RECORDATION CERTIFICATE
Filing Requirement of Act 74, Mich. P.A. 1970

SECTION

For corners in

<u>Presque Isle</u> (County)	Located in:	Corner Code #
1. Public Land Survey	T <u>35</u> N R <u>2E</u>	<u>K-2</u>
	T <u> </u> R <u> </u>	<u> </u>
	T <u> </u> R <u> </u>	<u> </u>
	T <u> </u> R <u> </u>	<u> </u>
2. Property Controlling in Section	S <u> </u> T <u> </u> R <u> </u>	<u> </u>
	S <u> </u> T <u> </u> R <u> </u>	<u> </u>
3. Miscellaneous Property in Sec.	S <u> </u> T <u> </u> R <u> </u>	<u> </u>
	S <u> </u> T <u> </u> R <u> </u>	<u> </u>

PRESQUE ISLE COUNTY
RECORDED

2000 DEC 11 AM 9:54

Janet M. Jamb
REGISTER OF DEEDS

Register of Deeds Stamp & File Number

4. Lot No. _____, Recorded Plat _____
5. Private Claims _____

I, Ronald Bischer, in a field survey on 10/24/00 do hereby state that under requirements of P.A. 74, Michigan P.A. of 1970, the corner points mentioned in lines 1 and 2 above were in conformance with regulations and rules therefore as required in the current manual of survey instructions of the United States Department of the Interior, Bureau of Land Management or by a decree of a Court of Law and for that the corner points mentioned in lines 3, 4 and 5 above were in conformance with the rules of the Michigan Board of Land Surveyors or by a Decree of a Court of Law; established, re-established, monumented, recovered, found as expressed below:

NOTE: Not more than 2 corners, all in the same town and range, may be recorded on this certificate.


	A	B	C	D	E	F	G	H	I	J	K	L	M
1													
2		6		5		4		3		2	●	1	
3													
4		7		8		9		10		11		12	
5													
6		18		17		16		15		14		13	
7													
8		19		20		21		22		23		24	
9													
10		30		29		28		27		26		25	
11													
12		31		32		33		34		35		36	
13													

A. Description of original monument and accessories and/or subsequent restoration:

Aug. 1855 George Cannon set wood post and 23 witnesses
1934+- Marcus Schaaf #3104 set 2" pipe in conc.
Aug. 1999 Ronald Bischer #22428 found 2" pipe and both OBT stumps
good blaze on stump to NW

B. Description of corner evidence found and/or method applied in restoring or reestablishing corner:

Found 2" pipe and both OBTs

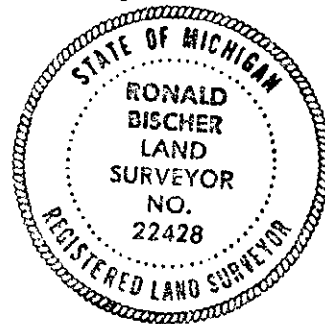

C. Description of monument for corner and accessories established to perpetuate locating the position of the corner:

Oct. 24, 2000
2" pipe with cap inside #22428
S54°W 39.31' 16" Spruce
N64°W 15.06' 13" Spruce
S66°E 19.79' 10" Balsam
N54°E 26.18' 5" Maple
Both OBTs in place with visible blazes
all 4 witnesses from 1999 good

Ratified by Peer Group
in accordance with P.A. 345
Chairman *Norman J. Quare*
Date 12-11-00

Signed by Ronald R. Bischer
Surveyor's Michigan License No. 22428

Date 11-7-2000