

FEB 12 2001

LIBER 340 PAGE 359

2000 PRESQUE ISLE COUNTY REMONUMENTATION

SECTION

LAND CORNER RECORDATION CERTIFICATE  
Filing Requirement of Act 74, Mich. P.A. 1970

PRESQUE ISLE COUNTY  
RECORDED

2000 DEC 11 AM 9:54

*Janet M. Jamt*  
REGISTER OF DEEDS

Register of Deeds Stamp & File Number

For corners in

<u>Presque Isle</u> (County)	Located In:	Corner Code #
1. Public Land Survey	T <u>35NR</u> 2E	<u>K-3</u>
	T ___ R ___	_____
	T ___ R ___	_____
	T ___ R ___	_____
2. Property Controlling in Section	S ___ T ___ R ___	_____
	S ___ T ___ R ___	_____
3. Miscellaneous Property in Sec.	S ___ T ___ R ___	_____
	S ___ T ___ R ___	_____

4. Lot No. \_\_\_\_\_, Recorded Plat \_\_\_\_\_  
5. Private Claims \_\_\_\_\_

I, Ronald Bischer, in a field survey on 10/24/00 do hereby state that under requirements of P.A. 74, Michigan P.A. of 1970, the corner points mentioned in lines 1 and 2 above were in conformance with regulations and rules therefore as required in the current manual of survey instructions of the United States Department of the Interior, Bureau of Land Management or by a decree of a Court of Law and/or that the corner points mentioned in lines 3, 4 and 5 above were in conformance with the rules of the Michigan Board of Land Surveyors or by a Decree of a Court of Law; established, re-established, monumented, recovered, found as expressed below:

NOTE: Not more than 2 corners, all in the same town and range, may be recorded on this certificate.


A	B	C	D	E	F	G	H	I	J	K	L	M
1												
2	6	5	4	3	2	1						
3												
4	7	8	9	10	11	12						
5												
6	18	17	16	15	14	13						
7												
8	19	20	21	22	23	24						
9												
10	30	29	28	27	26	25						
11												
12	31	32	33	34	35	36						
13												

A. Description of original monument and accessories and/or subsequent restoration:

Aug. 1855 George Cannon set wood post and 2 witnesses  
1934+- Marcus Schaaf #3104 set 4x4 cedar post  
1969 Delmer Porter #15410 found 4x4 cedar post set 1/2" rod  
December 1993 Ronald Bischer #22428 found 1/2" rod by 4x4 cedar post  
left 4 new witnesses

B. Description of corner evidence found and/or method applied in restoring or reestablishing corner:

found 1/2" rod and cap #15410 and 4x4 cedar post  
found 4 old Bischer witnesses and both OBTS in place

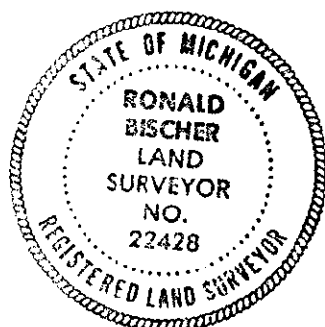

C. Description of monument for corner and accessories established to perpetuate locating the position of the corner:

Oct. 24, 2000  
1/2" rod and cap #15410  
N49° W 8.48' 10" Cedar  
N03° E 16.47' 7" Ash  
S52° E 8.82' 3" Cedar  
N39° E 13.68' 11" Cedar  
Both OBTS in place and visible

Ratified by Peer Group  
in accordance with P.A. 345  
Chairman *Norman J. Quinn*  
Date 12-11-00

Signed by Ronald R. Bischer  
Surveyor's Michigan License No. 22428

Date 11-7-2000