

Jenit M. Lamb
 REGISTER OF DEEDS

SURVEY &
 REMONUMENTATION
 FEB 12 2001

SECTION
 Register of Deeds Stamp & File Number

corners in

Presque Isle (County)	Located In:	Corner Code #
Public Land Survey	T 35N R 2E	K-9 ✓
	T 35N R 2E	K-10
	T R	
	T R	
	T R	
Property Controlling in Section	S T R	
	S T R	
	S T R	
	S T R	
Miscellaneous Property in Sec.	S T R	
	S T R	

Lot No. _____, Recorded Plat _____
 Private Claims _____

Delmer E Porter, in a field survey on 07/26/00, 19__ do hereby state that under requirements of P.A. 74, Michigan P.A. of 1970, the corner points mentioned in lines 1 and 2 above were in performance with regulations and rules therefore as required in the current manual of survey instructions of the United States Department of the Interior, Bureau of Land Management or by a decree of a Court of Law and/or if the corner points mentioned in lines 3, 4 and 5 above were in conformance with the rules of the Michigan Board of Land Surveyors or by a Decree of a Court of Law, established, re-established, monumented, covered, found as expressed below:

NOTE: Not more than 2 corners, all in the same town and range, may be recorded on this certificate.

	A	B	C	D	E	F	G	H	I	J	K	L	M
1													
2	6		5		4		3		2		1		
3													
4	7		8		9		10		11		12		
5													
6	18		17		16		15		14		13		
7													
8	19		20		21		22		23		24		
9													
10	30		29		28		27		26		25		
11													
12	31		32		33		34		35		36		
13													


Description of original monument and accessories and/or subsequent restoration:

K-9
 1/2" ROD & CAP #15410
 168° W 39.87' POWER POLE
 144° W 66.72' TELE POLE
 109° E 130.14' W. BIRCH

K-10
 1/2" ROD & CAP #15410
 N 10° W 157.07' P. POLE
 N 72° W 41.82' FE POST
 S 13° W 242.06' P. POLE

Description of corner evidence found and/or method applied in restoring or reestablishing corner:

K-9
 FOUND 1/2" ROD & CAP #15410
 168° W 39.87' P. POLE (OW)
 144° W 66.72' TELE POLE (OW)
 109° E 130.14' 12" W. BIRCH (OW)

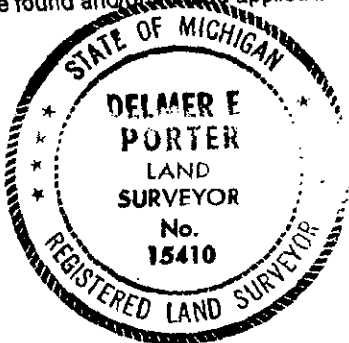

K-10
 FOUND 1/2" ROD & CAP #15410
 N 10° W 157.07' P. POLE (OW)
 S 13° W 242.06' P. POLE (OW)

Ratified by Peer Group
 in accordance with P.A. 345

Chairman *Norman J. Orsini*
 Date 10/27/00

Description of monument for corner and accessories established to perpetuate locating the position of the corner:

K-9
 1/2" ROD & CAP #15410
 168° W 39.87' P. POLE
 182° E 33.00' 1/2" ROD & CAP #15410
 109° E 130.14' 12" W. BIRCH
 144° W 66.72' TELE POLE

K-10
 1/2" ROD & CAP #15410
 N 10° W 157.07' P. POLE
 N 62° E 41.65' 5" CEDAR (BISCHER)
 S 42° E 44.25' 5" CEDAR (BISCHER)
 S 13° W 242.06' P. POLE

*WITNESS TAGS & NAILS USED.

Surveyed by *Delmer E Porter*
 Surveyor's Michigan License No. 15410

Date 10/5/00