

2000 PRESQUE ISLE COUNTY, STATE OF MICH. REMONUMENTATION

2000 OCT 30 PM 3: 28

LAND CORNER RECORDATION CERTIFICATE

Filing Requirement of Act 74, Mich. P.A. 1970

or corners in

Presque Isle (County)	Located In:	Corner Code #
Public Land Survey	T 35N R 2E	K-9
	T 35N R 2E	K-10 ✓
	T R	
	T R	
Property Controlling in Section	S T R	
	S T R	
Miscellaneous Property in Sec.	S T R	
	S T R	

Jane M. Lamb
REGISTER OF DEEDS

SURVEY & REMONUMENTATION

FEB 12 2001

SECTION

Register of Deeds Stamp & File Number

Lot No. _____, Recorded Plat _____
Private Claims _____

Delmer E. Porter, in a field survey on 07/26/00, 19__ do hereby state that under requirements of P.A. 74, Michigan P.A. of 1970, the corner points mentioned in lines 1 and 2 above were in conformance with regulations and rules therefore as required in the current manual of survey instructions of the United States Department of the Interior, Bureau of Land Management or by a decree of a Court of Law and/or that the corner points mentioned in lines 3, 4 and 5 above were in conformance with the rules of the Michigan Board of Land Surveyors or by a Decree of a Court of Law; established, re-established, monumented, covered, found as expressed below:

	A	B	C	D	E	F	G	H	I	J	K	L	M
1													
2		6		5		4		3		2		1	
3													
4		7		8		9		10		11		12	
5													
6		18		17		16		15		14		13	
7													
8		19		20		21		22		23		24	
9											●		
10		30		29		28		27		26	●	25	
11													
12		31		32		33		34		35		36	
13													

NOTE: Not more than 2 corners, all in the same town and range, may be recorded on this certificate.


Description of original monument and accessories and/or subsequent restoration:

K-9
1/2" ROD & CAP #15410
N 68° W 39.87' POWER POLE
S 44° W 66.72' TELE POLE
S 09° E 130.14' W. BIRCH

K-10
1/2" ROD & CAP #15410
N 10° W 157.07' P. POLE
N 72° W 41.82' FE POST
S 13° W 242.06' P. POLE

Description of corner evidence found and/or method applied in restoring or reestablishing corner:

K-9
FOUND 1/2" ROD & CAP #15410
N 68° W 39.87' P. POLE (OW)
S 44° W 66.72' TELE POLE (OW)
S 09° E 130.14' 12" W. BIRCH (OW)

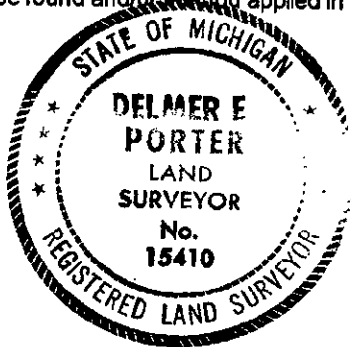

K-10
FOUND 1/2" ROD & CAP #15410
N 10° W 157.07' P. POLE (OW)
S 13° W 242.06' P. POLE (OW)

Ratified by Peer Group
in accordance with P.A. 345

Chairman *Norman J. Quane*

Date 10/27/00

Description of monument for corner and accessories established to perpetuate locating the position of the corner:

K-9
1/2" ROD & CAP #15410
N 68° W 39.87' P. POLE
S 82° E 33.00' 1/2" ROD & CAP #15410
S 09° E 130.14' 12" W. BIRCH
S 44° W 66.72' TELE POLE

K-10
1/2" ROD & CAP #15410
N 10° W 157.07' P. POLE
N 62° E 41.65' 5" CEDAR (BISCHER)
S 42° E 44.25' 5" CEDAR (BISCHER)
S 13° W 242.06' P. POLE

*WITNESS TAGS & NAILS USED.

Signed by *Delmer E. Porter*
Surveyor's Michigan License No. 15410

Date 10/5/00