

3649

FEB 12 2001

LIBER 340 PAGE 342

YEAR 2000 PRESQUE ISLE COUNTY, STATE OF MICHIGAN REMONUMENTATION SECTION

LAND CORNER RECORDATION CERTIFICATE
Filing Requirement of Act 74, Mich. P.A. 1970

Table with columns: For corners in PRESQUE ISLE (County), Located In: (Town, Range, Section), Corner Code #. Includes entries for Public Land Survey and Property Controlling in Section.


PRESQUE ISLE COUNTY RECORDED

2000 DEC 11 AM 9:48

Signature of Janet M. Samt, REGISTER OF DEEDS

Register of Deeds Stamp & File Number

4. Lot No. , Recorded Plat
5. Private Claims

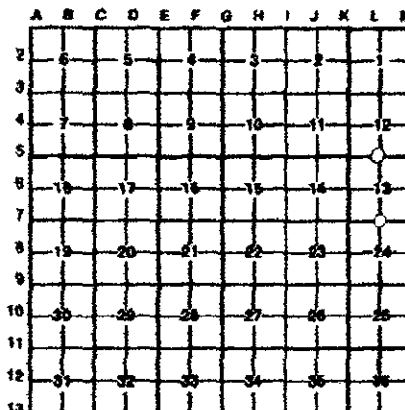

I, James A. Beck, in a field survey on Oct 9 and Oct 10, 2000, do hereby certify that under requirements of P.A. 74, Michigan P.A. of 1970, the corner points mentioned in lines 1 and 2 above were in conformance with regulations and rules therefore as required in the current manual of survey instructions of the United States Department of the Interior, Bureau of Land Management or by a decree of a Court of Law and/or that the corner points mentioned in lines 3, 4 and 5 above were in conformance with the rules of the Michigan Board of Land Surveyors or by a Decree of a Court of Law, established, re-established, monumented, re-monumented, recovered, found as expressed below.

NOTE: Not more than 4 corners, all in the same town and range, may be recorded on this certificate.

A. Description of original monument and accessories and/or subsequent restoration:

L5 October 24, 1974 P.A. 74 (Land Corner Recordation) Certificate by Delmer Porter P.S. 15410
fd. 1/2" pipe
South 33' fe. cor.
N80°W 33.87' 10' Ash
N15°E 2.20' 10' Ash clump
N85°E 8.06' 10' Twin Maple

L7 Nov 13, 1979, P.A. 74 (Land Corner Recordation) Certificate by Delmer Porter P.S. 15410
1/2" rod in monument box
N04°E 41.17' Fence Corner
S50°E 82.20' P/Pole
N64°E 41.10' Fence Corner
N59°E 70.32' Fence Post

B. Description of corner evidence found and/or method applied in restoring or reestablishing corner:

L5 October 10, 2000 Remonumentation found 1/2" pipe, set P.S. 21559 cap in pipe
Witnesses found:
N5°E 2.20' 10' Ash
N85°E 8.06' twin 14"-18" Maple

L7 October 9, 2000 Remonumentation Found 1/2" iron rod in monument box, set cap on rod
Witnesses found:
S50°E 82.20' old power pole base

Ratified by Peer Group in accordance with P.A. 345
Chairman Norman J. Christie
Date 12-11-00

C. Description of monument for corner and accessories established to perpetuate locating the position of the corner:


L5 October 10, 2000 Remonumentation 1/2" pipe and P.S. 21559 cap
Witnesses:
N5°E 2.20' P.S. 21559 tag in 10' Ash
N85°E 8.06' P.S. 21559 tag in twin 14"-18" Maple
N52°W 31.45' P.S. 22435 tag in 16" Maple
N16°W 33.70' P.S. 22435 tag in 18" Maple

L7 October 9, 2000 Remonumentation 1/2" iron rod and P.S. 21559 cap in monument box
Witnesses:
S50°E 82.20' old power pole base
S54°E 81.90' P.S. 21559 tag in new power pole
S33°E 83.75' P.S. 21559 tag in 4" Maple
S19°E 84.50' P.S. 21559 tag in 5" Maple
S1°W 76.65' P.S. 21559 tag in 7" Maple
in cluster of four
Corner falls in North lane of Blacktop highway

Corner falls at old tree/fence line at N side of lane East and at East side of 2 rut road to North

Signed by James A. Beck P.S. 21559

Surveyor's Michigan License No.

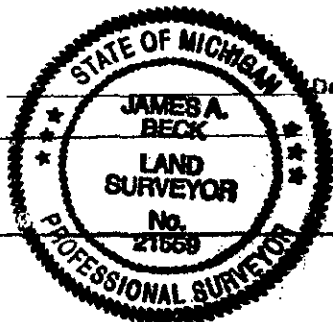

Date Nov. 7, 2000