

2000 PRESQUE ISLE COUNTY, STATE OF MICH. REMONUMENTATION

2000 OCT 30 PM 3: 28

LAND CORNER RECORDATION CERTIFICATE
Filing Requirement of Act 74, Mich. P.A. 1970

For corners in

Presque Isle (County)	Located In:	Corner Code #
1. Public Land Survey	T 35N R 2E	L-9 ✓
	T 35N R 2E	L-11
	T ___ R ___	_____
	T ___ R ___	_____
2. Property Controlling in Section	S ___ T ___ R ___	_____
	S ___ T ___ R ___	_____
3. Miscellaneous Property in Sec.	S ___ T ___ R ___	_____
	S ___ T ___ R ___	_____

Jane M. Lamb
REGISTER OF DEEDS

SURVEY &
REMONUMENTATION

FEB 12 2001

SECTION

Register of Deeds Stamp & File Number

4. Lot No. _____, Recorded Plat _____
5. Private Claims _____

I, Delmer E. Porter, in a field survey on 09/5/00, 19__ do hereby state that under requirements of P.A. 74, Michigan P.A. of 1970, the corner points mentioned in lines 1 and 2 above were in conformance with regulations and rules therefore as required in the current manual of survey instructions of the United States Department of the Interior, Bureau of Land Management or by a decree of a Court of Law and /or that the corner points mentioned in lines 3, 4 and 5 above were in conformance with the rules of the Michigan Board of Land Surveyors or by a Decree of a Court of Law; established, re-established, monumented, recovered, found as expressed below:

NOTE: Not more than 2 corners, all in the same town and range, may be recorded on this certificate.

	A	B	C	D	E	F	G	H	I	J	K	L	M
1													
2	6		5		4		3		2		1		
3													
4	7		8		9		10		11		12		
5													
6	18		17		16		15		14		13		
7													
8	19		20		21		22		23		24		
9													
10	30		29		28		27		26		25		
11													
12	31		32		33		34		35		36		
13													


A. Description of original monument and accessories and/or subsequent restoration:

L-9
1/2" ROD & CAP #15410
N 38° W 45.10' 6" MAPLE
N 54° E 164.63' 10" MAPLE

L-11
1/2" ROD
NORTH 33.49' FE POST
S 04° W 32.67' FE COR
S 37° W 38.30' FE POST

B. Description of corner evidence found and/or method applied in restoring or reestablishing corner:

L-9
FOUND 1/2" ROD & CAP #15410
N 38° W 45.10' 9" MAPLE (OW)

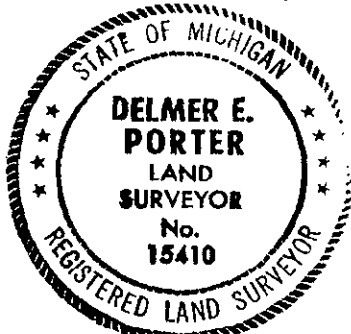

L-11
FOUND 1/2" ROD & CAP #22428
S 04° W 32.67' FE COR (OW)
S 37° W 38.30' FE POST (OW)

Ratified by Peer Group
in accordance with P.A. 345
Chairman *Norman J. Crain*
Date 10/27/00

C. Description of monument for corner and accessories established to perpetuate locating the position of the corner:

L-9
1/2" ROD & CAP #15410
S 44° W 30.71' 3" BIRCH
N 38° W 45.10' 9" MAPLE
N 22° W 58.90' 12" TWIN MAPLE
N 04° E 57.24' 4" BIRCH

L-11
1/2" ROD & CAP #22428
S 04° W 32.67' FE COR
S 37° W 38.30' FE POST
N 58° W 61.99' 4" APPLE - TAG IN BRANCH
N 37° W 34.00' 3" ELM

*WITNESS TAGS & NAILS USED.

Signed by *Delmer E. Porter*
Surveyor's Michigan License No. 15410

Date 10/5/00