

FEB 12 2001

LIBER 340 PAGE 362

2000 PRESQUE ISLE COUNTY REMONUMENTATION

SECTION

LAND CORNER RECORDATION CERTIFICATE  
Filing Requirement of Act 74, Mich. P.A. 1970

PRESQUE ISLE COUNTY  
RECORDED

2000 DEC 11 AM 9:55

*Just M. Lamb*  
REGISTER OF DEEDS

Register of Deeds Stamp & File Number

For corners in

Presque Isle  
(County)

Located In:

Corner Code #

- 1. Public Land Survey      T 35NR2E      M-3
- T \_\_\_ R \_\_\_      \_\_\_\_\_
- T \_\_\_ R \_\_\_      \_\_\_\_\_
- T \_\_\_ R \_\_\_      \_\_\_\_\_
- 2. Property Controlling    S \_\_\_ T \_\_\_ R \_\_\_      \_\_\_\_\_
- in Section                S \_\_\_ T \_\_\_ R \_\_\_      \_\_\_\_\_
- 3. Miscellaneous            S \_\_\_ T \_\_\_ R \_\_\_      \_\_\_\_\_
- Property in Sec.         S \_\_\_ T \_\_\_ R \_\_\_      \_\_\_\_\_

- 4. Lot No. \_\_\_\_\_, Recorded Plat \_\_\_\_\_
- 5. Private Claims \_\_\_\_\_

I, Ronald Bischer, in a field survey on 10/24/00 do hereby state that under requirements of P.A. 74, Michigan P.A. of 1970, the corner points mentioned in lines 1 and 2 above were in conformance with regulations and rules therefore as required in the current manual of survey instructions of the United States Department of the Interior, Bureau of Land Management or by a decree of a Court of Law and/or that the corner points mentioned in lines 3, 4 and 5 above were in conformance with the rules of the Michigan Board of Land Surveyors or by a Decree of a Court of Law; established, re-established, monumented, recovered, found as expressed below:

NOTE: Not more than 2 corners, all in the same town and range, may be recorded on this certificate.


	A	B	C	D	E	F	G	H	I	J	K	L	M
1													
2	6		5		4		3		2		1		
3													
4	7		8		9		10		11		12		
5													
6	10		17		16		15		14		13		
7													
8	19		20		21		22		23		24		
9													
10	30		29		28		27		26		25		
11													
12	31		32		33		34		35		36		
13													

A. Description of original monument and accessories and/or subsequent restoration:

June 1840 John Hodgson set wood post and 2 witnesses  
Aug. 1855 George Cannon set new post and new 2 witnesses  
Nov. 1979 Delmer Porter #15410 found 4x4 cedar stake could have been Marcus Schaaf old trail going north and south set Remon mon and 3 witnesses

B. Description of corner evidence found and/or method applied in restoring or reestablishing corner:

found 4x4 cedar stake and remon mon and 1 old witness

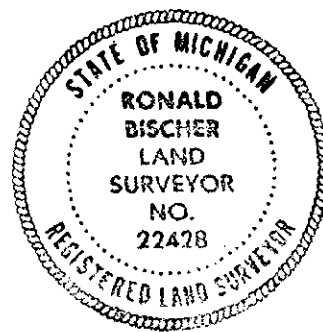

C. Description of monument for corner and accessories established to perpetuate locating the position of the corner:

Oct. 24, 2000  
Remon mon and  
N06°W 23.73' 5" Maple  
N76°W 19.87' 5" Maple  
N54°E 15.00' 4" Spruce  
S67°E 8.38' 4" Spruce

Ratified by Peer Group  
in accordance with P.A. 345  
Chairman *Norman J. Quinn*  
Date 12-11-00

Signed by Ronald R. Bischer  
Surveyor's Michigan License No. 22428

Date 11-7-2000