

3648

FEB 12 2001

LIBER 340 PAGE 341

YEAR 2000 PRESQUE ISLE COUNTY, STATE OF MICHIGAN REMONUMENTATION SECTION

LAND CORNER RECORDATION CERTIFICATE
Filing Requirement of Act 74, Mich. P.A. 1970

PRESQUE ISLE COUNTY
RECORDED

2000 DEC 11 AM 9:48

Janet M. Jamb
REGISTER OF DEEDS

For corners in
PRESQUE ISLE
(County)


Located In:

Corner Code #/

1. Public Land Survey	T <u>35N</u> R <u>2E</u>	M <u>5</u> ✓
	T <u>35N</u> R <u>2E</u>	M <u>6</u>
	T _____ R _____	_____
	T _____ R _____	_____
2. Property Controlling In Section	S _____ T _____ R _____	_____
	S _____ T _____ R _____	_____
3. Miscellaneous Property in Sec.	S _____ T _____ R _____	_____
	S _____ T _____ R _____	_____

Register of Deeds Stamp & File Number

4. Lot No. _____, Recorded Plat _____
5. Private Claims _____

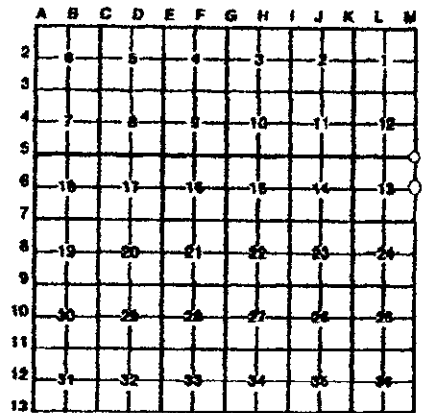

I, James A. Beck, in a field survey on Oct 9, 2000, do hereby certify that under requirements of P.A. 74, Michigan P.A. of 1970, the corner points mentioned in lines 1 and 2 above were in conformance with regulations and rules therefore as required in the current manual of survey instructions of the United States Department of the Interior, Bureau of Land Management or by a decree of a Court of Law and/or that the corner points mentioned in lines 3, 4 and 5 above were in conformance with the rules of the Michigan Board of Land Surveyors or by a Decree of a Court of Law; established, re-established, monumented, re-monumented, recovered, found as expressed below:

NOTE: Not more than 4 corners, all in the same town and range, may be recorded on this certificate.

A. Description of original monument and accessories and/or subsequent restoration:

M 5 Sep 17, 1990, P.A. 74 (Land Corner Recordation)
Certificate by Carl Johnson
(recorded as A 5 in T35N, R3E)
found wheel hub in "T" Rd. intersection
power pole N28°W 64.42'
Maple 14°S55°W 68.75'
Apple 18° N70°E 75.4

M 6 October 12, 1974, P.A. 1974 (Land Corner Recordation) Certificate
by Delmer Porter P.S. 15410
1" bar
Witnesses:
West 33.90' fe post
N50°W 44.08' p. pole
S45°E 40.38' fe. cor.

B. Description of corner evidence found and/or method applied in restoring or reestablishing corner:

M 5 October 9, 2000 Remonumentation
Found buggy wheel hub in Gravel roadway,
Set P.S. 21559 cap in center of hub
N28°W 64.10' DNR tag in power pole
S67°W 68.75' 16" Maple

M 6 October 9 2000 Remonumentation
Found 1" Bar at Corner
Witnesses found:
West 34.50' RLS 15410 tag in leaning fence post
N50°W 44.08' RLS 15410 tag in power pole

Ratified by Peer Group
in accordance with P.A. 345

Chairman *Norman J. ...*

Date 12-11-00

C. Description of monument for corner and accessories established to perpetuate locating the position of the corner:

M 5 October 9, 2000 Remonumentation
Buggy wheel hub in Gravel roadway, with
P.S. 21559 cap in center of hub
N28°W 64.10' DNR tag in power pole
East 35.82' fence cor post (unstable)
N55°E 70.2' felt washer in 18" Apple
S67°W 68.75' P.S. 21559 tag in 16" Maple
N17°W 60.2' P.S. 21559 tag in 10" Red Pine
Corner falls in North-South gravel roadway 3' + or - West of
center and 4' + or - South of center gravel road West extended

M 6 October 9 2000 Remonumentation
Found 1" Bar at Corner
West 34.50' RLS 15410 tag in leaning fence post
N50°W 44.08' RLS 15410 tag in power pole
S58°E 82.80' P.S. 21559 tag in 6" Red Pine
N15°E 101.0' near corner of sign post ("Dead End
Road)
Corner falls in North-South gravel roadway

Signed by *James A. Beck*
James A. Beck P.S. 21559

Date Nov. 7, 2000

Surveyor's Michigan License No. _____

