

3648

SURVEY & REMONUMENTATION

FEB 12 2001

LIBER 340 PAGE 341

YEAR 2000 PRESQUE ISLE COUNTY, STATE OF MICHIGAN REMONUMENTATION SECTION

LAND CORNER RECORDATION CERTIFICATE

Filing Requirement of Act 74, Mich. P.A. 1970

PRESQUE ISLE COUNTY RECORDED

2000 DEC 11 AM 9:48

James M. Jamet REGISTER OF DEEDS

Register of Deeds Stamp & File Number


For corners in PRESQUE ISLE (County)

Located in:

Corner Code #

Table with 3 columns: Survey Type, Location (T/R, S/T), and Corner Code. Includes entries for Public Land Survey, Property Controlling in Section, and Miscellaneous Property in Sec.

4. Lot No. Recorded Plat
5. Private Claims

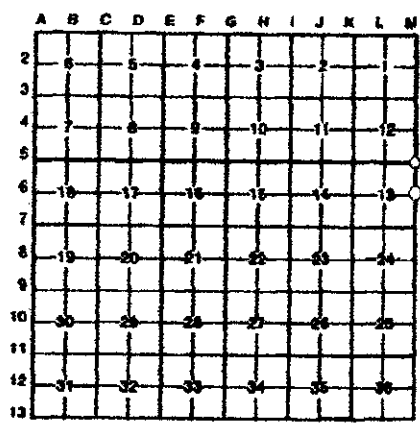

I, James A. Beck, in a field survey on Oct 9, 2000, do hereby certify that under requirements of P.A. 74, Michigan P.A. of 1970, the corner points mentioned in lines 1 and 2 above were in conformance with regulations and rules therefore as required in the current manual of survey instructions of the United States Department of the Interior, Bureau of Land Management or by a decree of a Court of Law and/or that the corner points mentioned in lines 3, 4 and 5 above were in conformance with the rules of the Michigan Board of Land Surveyors or by a Decree of a Court of Law; established, re-established, monumented, re-monumented, recovered, found as expressed below:

NOTE: Not more than 4 corners, all in the same town and range, may be recorded on this certificate.

- A. Description of original monument and accessories and/or subsequent restoration:
M5 Sep 17, 1990, P.A. 74 (Land Corner Recordation) Certificate by Carl Johnson...
M6 October 12, 1974, P.A. 1974 (Land Corner Recordation) Certificate by Delmer Porter P.S. 15410...

- B. Description of corner evidence found and/or method applied in restoring or reestablishing corner:
M5 October 9, 2000 Remonumentation Found buggy wheel hub in Gravel roadway...
M6 October 9 2000 Remonumentation Found 1" Bar at Corner...

Ratified by Peer Group in accordance with P.A. 345
Chairman Norman J. ...
Date 12-11-00

- C. Description of monument for corner and accessories established to perpetuate locating the position of the corner:
M5 October 9, 2000 Remonumentation Buggy wheel hub in Gravel roadway, with P.S. 21559 cap in center of hub...
M6 October 9 2000 Remonumentation Found 1" Bar at Corner...

Signed by James A. Beck P.S. 21559
Surveyor's Michigan License No.

Date Nov. 7, 2000

