

FEB 12 2001

LIBER 340 PAGE 340

YEAR 2000 PRESQUE ISLE COUNTY, STATE OF MICHIGAN REMONUMENTATION SECTION

LAND CORNER RECORDATION CERTIFICATE

Filing Requirement of Act 74, Mich. P.A. 1970

For corners in PRESQUE ISLE

(County)

Located in:

Corner Code #

1. Public Land Survey

T 35N R 2E

M 7

T 35N R 2E

M 8

T R

T R

2. Property Controlling in Section

S T R

S T R

3. Miscellaneous Property in Sec.

S T R

S T R

PRESQUE ISLE COUNTY RECORDED

2000 DEC 11 AM 9:48

Janet M. Jamt REGISTER OF DEEDS

Register of Deeds Stamp & File Number

4. Lot No. , Recorded Plat

5. Private Claims

Grid table with columns A-M and rows 2-13. Contains numbers 1-36 and some circles.

James A. Beck in a field survey on Oct 9 & Oct 27, 2000 do hereby certify that under requirements of P.A. 74, Michigan P.A. of 1970, the corner points mentioned in lines 1 and 2 above were in conformance with regulations and rules therefore as required in the current manual of survey instructions of the United States Department of the Interior, Bureau of Land Management or by a decree of a Court of Law and/or that the corner points mentioned in lines 3, 4 and 5 above were in conformance with the rules of the Michigan Board of Land Surveyors or by a Decree of a Court of Law; established, re-established, monumented, re-monumented, recovered, found as expressed below:

NOTE: Not more than 4 corners, all in the same town and range, may be recorded on this certificate.

A. Description of original monument and accessories and/or subsequent restoration:

M 7 Sep 26, 1978 P.A. 74 (Land Corner Recordation) Certificate by Delmer Porter R.L.S. 15410 1/2" rod in monument box witnesses: S62°E 90.97' p. pole N48°E 51.46' fa. cor N66°E 86.82' 4" Apple S52°E 105.61' 3" Apple S37°W 67.44' 4" Maple

M 8 June 10, 1988 P.A. 74 (Land Corner Recordation Certificate) by Ronald Biecher 22428 set 1/2" rod by single proportion 1/2" rod N9°E 17.98' 7" Maple N55°W 9.12' 9" Maple S79°W 8.02' 5" Maple

B. Description of corner evidence found and/or method applied in restoring or reestablishing corner:

M 7 October 9, 2000 Remonumentation Found 1/2" iron rod in monument box, set P.S. 21559 cap Witnesses found: N66°E 86.82' 5" Apple in clump (R.L.S. 15410 tag) S62°E 90.85' R.L.S. 15410 tag in Power pole N48°E 51.5' fence cor post (leaning) S37°W 67.44' R.L.S. 15410 tag in 4" dead Maple

M 8 Oct 27, 2000 Remonumentation Found 1/2" iron rod and P.S. 22428 cap Witnesses found: N9°E 17.98", 9" Maple (old witness) N55°W 9.12', 12" Maple (old witness)

Ratified by Peer Group in accordance with P.A. 345 Chairman Norman J. Duane Date 12-11-00


C. Description of monument for corner and accessories established to perpetuate locating the position of the corner:

M 7 October 9, 2000 Remonumentation 1/2" iron rod and P.S. 21559 cap in monument box Witnesses: N66°E 86.82' 5" Apple in clump (R.L.S. 15410 tag) S62°E 90.85' R.L.S. 15410 tag in Power pole S26°E 78.00', P.S. 21559 tag in 8" Tamarack S48°W 46.20' near corner of Tel cable box N48°E 51.5' fence cor post (leaning) S37°W 67.44' R.L.S. 15410 tag in 4" dead Maple Cor falls in East-West blacktop roadway

M 8 Oct 27, 2000 Remonumentation 1/2" iron rod and P.S. 22428 cap Witnesses: N9°E 17.98", 9" Maple (old witness) N55°W 9.12', 12" Maple (old witness) N55°E 23.61' P.S. 21559 cap in 14" Maple S3°W 73.36', near face tall metal game enclosure fence post Corner falls at Southerly side of hardwood low lands to North and cleared strip with game enclosure fence running East and West to the South.

Signed by James A. Beck P.S. 21559

Surveyor's Michigan License No.

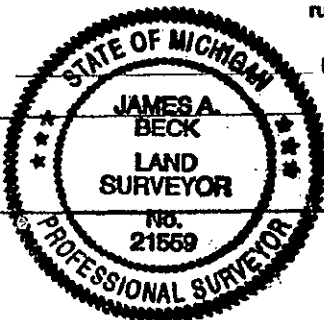

Date Nov. 7, 2000