

2354

2000 PRESQUE ISLE COUNTY, STATE OF MICH

PRESQUE ISLE COUNTY
RECORDED

REMONUMENTATION
LAND CORNER RECORDATION CERTIFICATE
Filing Requirement of Act 74, Mich. P.A. 1970

OCT 30 PM 3:28

For corners in

Presque Isle
(County)

Located in:

Corner Code #

1. Public Land Survey

T 35N R 2E

M-11

T 35N R 2E

M-12 ✓

T R

T R

2. Property Controlling
in Section

S

T R

S

T R

3. Miscellaneous
Property in Sec.

S

T R

S

T R

4. Lot No. _____, Recorded Plat _____

5. Private Claims _____

Janet M. Lamb
REGISTER OF DEEDS

SURVEY &
REMONUMENTATION

FEB 12 2001

SECTION

Register of Deeds Stamp & File Number

	A	B	C	D	E	F	G	H	I	J	K	L	M
1													
2	6		5		4		3		2		1		
3													
4	7		8		9		10		11		12		
5													
6	18		17		16		15		14		13		
7													
8	19		20		21		22		23		24		
9													
10	30		29		28		27		26		25		
11													
12	31		32		33		34		35		36		
13													

I, Delmer E. Porter, in a field survey on 09/6/00, 19 do hereby state that under requirements of P.A. 74, Michigan P.A. of 1970, the corner points mentioned in lines 1 and 2 above were in conformance with regulations and rules therefore as required in the current manual of survey instructions of the United States Department of the Interior, Bureau of Land Management or by a decree of a Court of Law and/or that the corner points mentioned in lines 3, 4 and 5 above were in conformance with the rules of the Michigan Board of Land Surveyors or by a Decree of a Court of Law; established, re-established, monumented, recovered, found as expressed below:

NOTE: Not more than 2 corners, all in the same town and range, may be recorded on this certificate.


A. Description of original monument and accessories and/or subsequent restoration:

M-11
CONC MON/BRASS CAP
N 45° W 47.48' FE COR
N 06° W 16.82' E GATE POST
S 10° E 40.03' 9" ELM

M-12
CONC MON/BRASS CAP
N 20° W 1.04' 7" CEDAR
N 29° E 13.76' 9" SPRUCE
S 69° E 7.19' 9" CEDAR

B. Description of corner evidence found and/or method applied in restoring or reestablishing corner:

M-11
FOUND CONC MON/BRASS CAP
NO WITNESSES REMAINING

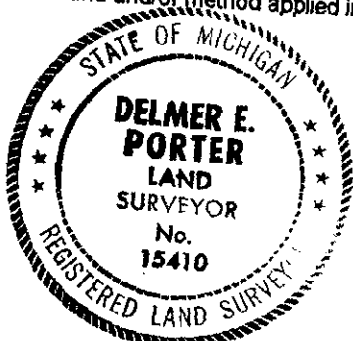

M-12
FOUND CONC MON/BRASS CAP
N 20° W 1.04' 7" CEDAR (OW)
S 69° E 7.19' 9" CEDAR (OW)

Ratified by Peer Group
in accordance with P.A. 345

Chairman *William J. Quinn*
Date 10/27/00

C. Description of monument for corner and accessories established to perpetuate locating the position of the corner:

M-11
CONC MON/BRASS CAP
N 09° W 81.97' FE POST (1ST WEST OF GATE)
N 02° W 79.47' GATE POST
N 08° E 78.64' E GATE POST
N 78° E 43.12' 11" POPLAR

M-12
CONC MON/BRASS CAP
S 66° W 10.00' 12" TWIN CEDAR
N 20° W 1.04' 7" CEDAR
N 10° E 8.87' 9" CEDAR
S 69° E 7.19' 9" CEDAR

*WITNESS TAGS & NAILS USED.

Signed by *Delmer E. Porter*

Surveyor's Michigan License No. 15410

Date 10/5/00