2198 SURVEY & MONUMENTATION

1995 PRESQUE ISLE COUNTY, STATE OF MICHIGAN REMONUMENTATION

PRESQUE ISLE COUNTY RECORDED

JAN 17 1996 COMMISSION

95 OCT 20 PM 4:26

Janet M. Lamb
REGISTER OF DEEDS

LIBER 316 PAGE 281

Register of Deeds Stamp & File Number

LAND CORNER RECORDATION CERTIFICATE

Filing Requirement of Act 74, Mich. P.A. 1970

For corners in Presque Isle (County)

	Located In:	Corner Code #1
1. Public Land Survey	T 36N R 2E	A-6
	T ___ R ___	
	T ___ R ___	
	T ___ R ___	
2. Property Controlling	S ___ T ___ R ___	
in Section	S ___ T ___ R ___	
3. Miscellaneous	S ___ T ___ R ___	
Property in Sec.	S ___ T ___ R ___	

4. Lot No. _____, Recorded Plat _____
5. Private Claims _____

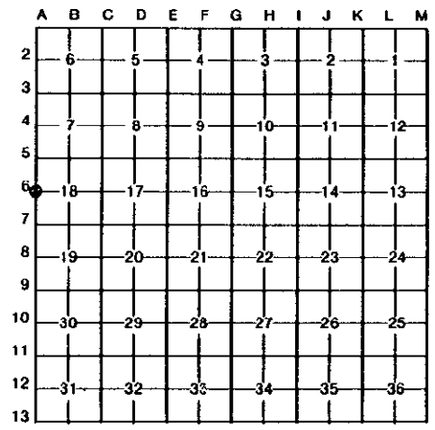

I, Norman J. Quaine, in a field survey on March 31, 19 95, do hereby certify that under requirements of P.A. 74, Michigan P.A. of 1970, the corner points mentioned in lines 1 and 2 above were in conformance with regulations and rules therefore as required in the current manual of survey instructions of the United States Department of the Interior, Bureau of Land Management or by a decree of a Court of Law and/or that the corner points mentioned in lines 3, 4 and 5 above were in conformance with the rules of the Michigan Board of Land Surveyors or by a Decree of a Court of Law; established, re-established, monumented, re-monumented, recovered, found as expressed below:

NOTE: Not more than 4 corners, all in the same town and range, may be recorded on this certificate.

A. Description of original monument and accessories and/or subsequent restoration:

A-6
GLO Notes
Resurvey 1856
Sp. Pine 8" S64° E 134½
Sp. Pine 8" N67° W 59
George H. Cannon

11-6-78
Presque Isle County
Local Remonumentation
LCRC Page 340
Delmer E. Porter
#15410

Fd. Conc Mon
Left Same
N50° W 46.71' 7" N. Pine
S69° W 45.12' 7" N. Pine
S24° E 57.41' P. Pole

B. Description of corner evidence found and/or method applied in restoring or reestablishing corner:

A-6
March 31, 1995
Presque Isle County
State Remonumentation
Norman J. Quaine #33984
Porter's Survey P.C.

Fd conc Mon & Cap "Doyle"
N48° W 46.66' 9" N. Pine
S22° E 57.45' P. Pole
S70° W 45.20' 9" N. Pine

C. Description of monument for corner and accessories established to perpetuate locating the position of the corner:

A-6
Left conc Mon & Cap "Doyle"
N48° W 46.66' 9" N. Pine
N78° E 57.22' 11" Aspen
S22° E 57.45' P. Pole
S70° W 45.20' 9" N. Pine

*Witness tags & nails used.

Ratified by Peer Group in accordance with P.A. 345
Chairman Delmer E. Porter
Date 9/20/95

Signed by Norman J. Quaine Date October 19, 1995
Surveyor's Michigan License No. 33984

FORM APPROVED BY MICHIGAN STATE BOARD OF LAND SURVEYORS, JAN. 28, 1971
REVISED MAY 14, 1975
REVISED JAN., 1983