

State of Michigan Remonumentation Project 1994
 Presque Isle County, Michigan.

PRESQUE ISLE COUNTY
 RECORDED

LAND CORNER RECORDATION CERTIFICATE
 Filing Requirement of Act 74, Mich. P.A. 1970

94 SEP -6 AM 10: 10

For corners in

Presque Isle Located In: Corner Code #
 (County)

1. Public Land Survey T 36N R 2E A-9
 T _____ R _____
 T _____ R _____
 T _____ R _____

2. Property Controlling S _____ T _____ R _____
 in Section S _____ T _____ R _____

3. Miscellaneous S _____ T _____ R _____
 Property in Sec. S _____ T _____ R _____

Janet M. Lamb
 REGISTER OF DEEDS

LIBER **311** PAGE **116**

Register of Deeds Stamp & File Number

4. Lot No. _____, Recorded Plat _____ SECTION _____
 5. Private Claims _____

I, Norman J. Quaine in a field survey on March 7, 1994, do hereby certify that under requirements of P.A. 74, Michigan P.A. of 1970, the corner points mentioned in lines 1 and 2 above were in conformance with regulations and rules therefore as required in the current manual of survey instructions of the United States Department of the Interior, Bureau of Land Management or by a decree of a Court of Law and/or that the corner points mentioned in lines 3, 4 and 5 above were in conformance with the rules of the Michigan Board of Land Surveyors or by a Decree of a Court of Law; established, re-established, monumented, re-monumented, recovered, found as expressed below:

	A	B	C	D	E	F	G	H	I	J	K	L	M
2	6	5	4	3	2	1							
3													
4	7	8	9	10	11	12							
5													
6	18	17	16	15	14	13							
7													
8	19	20	21	22	23	24							
9													
10	30	29	28	27	26	25							
11													
12	31	32	33	34	35	36							
13													

NOTE: Not more than 4 corners, all in the same town and range, may be recorded on this certificate.

A. Description of original monument and accessories and/or subsequent restoration:

A-9
 GLO Notes Aspen 12" N40°W 28 Lks. 11-1-78 Fd. 2" Pipe & witness
 Resurvey 1856 W. Pine 10" S52°W 5 Lks. P. I. Co. replaced with 4" Conc
 9-11-76 Found 2" Pipe while Remon. mon. w/brass cap
 Porter's Survey File performing survey in Project lettered "P. I. Co.
 Records Section 30 Rec. 11/6/78 Remonumentation"
 L.C.R.C. N07°W 45.25' 17" Maple L.C.R.C. Pg. 341 N07°W 45.25' 17"
 Delmer E. Porter N65°W 20.81' 10" Tw. Delmer E. Maple
 LS#15410 Maple Porter #15410 N65°W 20.81' 10"
 Tw. Maple

B. Description of corner evidence found and/or method applied in restoring or reestablishing corner:


A-9
 Presque Isle County Found conc. Mon. & P. I. Co.
 State Remonumentation Remonumentation with brass cap
 Norman J. Quaine N07°W 45.25' 16" Maple in poor condition
 #33984, Porter's
 Survey P.C.

**Ratified by Peer Group
 in accordance with P.A. 345**

Chairman *Delmer E. Porter*
Date August 29, 1994

C. Description of monument for corner and accessories established to perpetuate locating the position of the corner:

A-9
 Conc. Mon. & P. I. Co.
 Remon. Brass Cap
 N00°W 23.64' 6" White Pine
 N77°E 63.65' 6" Ash
 S30°E 50.29' 7" Maple
 S74°W 39.21' 12" Twin Maple

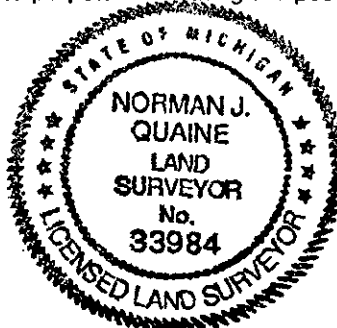

Signed by Norman J. Quaine Date August 29, 1994
 Surveyor's Michigan License No. 33984