2199

SURVEY & MONUMENTATION

1995 PRESQUE ISLE COUNTY, STATE OF MICHIGAN REMONUMENTATION

PRESQUE ISLE COUNTY RECORDED

JAN 17 1996 COMMISSION

LAND CORNER RECORDATION CERTIFICATE

Filing Requirement of Act 74, Mich. P.A. 1970

95 OCT 20 PM 4:26

Janet M. Slamp
REGISTER OF DEEDS

LIBER 316 PAGE 282

Register of Deeds Stamp & File Number

For corners in Presque Isle (County)

	Located In:	Corner Code #
1. Public Land Survey	T 36N R 2E	B-1
	T ___ R ___	
	T ___ R ___	
	T ___ R ___	
2. Property Controlling	S ___ T ___ R ___	
in Section	S ___ T ___ R ___	
3. Miscellaneous	S ___ T ___ R ___	
Property in Sec.	S ___ T ___ R ___	

4. Lot No. _____, Recorded Plat _____

5. Private Claims _____

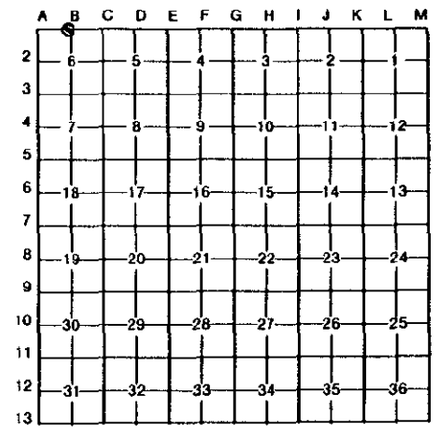

I, Norman J. Quaine, in a field survey on April 4, 19 95, do hereby certify that under requirements of P.A. 74, Michigan P.A. of 1970, the corner points mentioned in lines 1 and 2 above were in conformance with regulations and rules therefore as required in the current manual of survey instructions of the United States Department of the Interior, Bureau of Land Management or by a decree of a Court of Law and/or that the corner points mentioned in lines 3, 4 and 5 above were in conformance with the rules of the Michigan Board of Land Surveyors or by a Decree of a Court of Law; established, re-established, monumented, re-monumented, recovered, found as expressed below:

NOTE: Not more than 4 corners, all in the same town and range, may be recorded on this certificate.

A. Description of original monument and accessories and/or subsequent restoration:

B-1
GLO Notes
Resurvey 1856
Black Ash 24" N40° W 21
Cedar 8" N30° E 16
George H. Cannon

B. Description of corner evidence found and/or method applied in restoring or reestablishing corner:

B-1
April 4, 1995
Presque Isle County
State Remonumentation
Norman J. Quaine #33984
Porter's Survey P.C.

Fd. no evidence of corner's position
Set 1/2" Rod & Cap #33984
By Single Proportion

C. Description of monument for corner and accessories established to perpetuate locating the position of the corner:

B-1
Left 1/2" Rod & Cap #33984
S54° E 22.76' 4" Ash
S73° E 54.79' 4" Cedar
S02° W 22.58' 3" Balsam
N20° W 52.64' 5" Ash

Ratified by Peer Group
in accordance with P.A. 345
Chairman Delmar L. Porter
Date 9/20/95

*Witness tags & nails used.

Signed by Norman J. Quaine Date OCTOBER 19, 1995

Surveyor's Michigan License No. 33984

FORM APPROVED BY MICHIGAN STATE BOARD OF LAND SURVEYORS, JAN. 26, 1971
REVISED MAY 14, 1975
REVISED JAN., 1983