3200 SURVEY &

1995 PRESQUE ISLE COUNTY STATE OF MICHIGAN REMONUMENTATION

PRESQUE ISLE COUNTY
RECORDED
95 OCT 20 PM 4:26
Janice M. Lamb
REGISTER OF DEEDS

JAN 17 1996

COMMISSION

LAND CORNER RECORDATION CERTIFICATE

Filing Requirement of Act 74, Mich. P.A. 1970

LIBER 316 PAGE 283

Register of Deeds Stamp & File Number

For corners in Presque Isle (County) Located In:

		Corner Code #
1. Public Land Survey	T 36N R 2E	B-3
	T ___ R ___	
	T ___ R ___	
	T ___ R ___	
2. Property Controlling	S ___ T ___ R ___	
in Section	S ___ T ___ R ___	
3. Miscellaneous	S ___ T ___ R ___	
Property in Sec.	S ___ T ___ R ___	

4. Lot No. _____, Recorded Plat _____
5. Private Claims _____

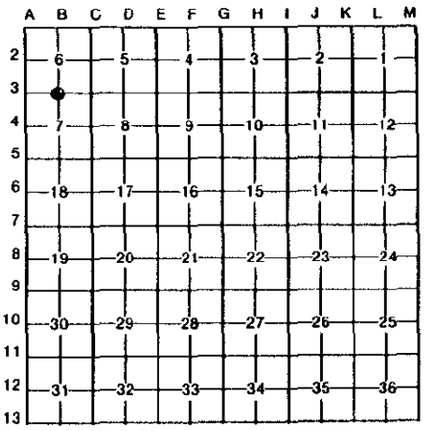

I, Norman J. Quaine in a field survey on May 8, 19 95, do hereby certify that under requirements of P.A. 74, Michigan P.A. of 1970, the corner points mentioned in lines 1 and 2 above were in conformance with regulations and rules therefore as required in the current manual of survey instructions of the United States Department of the Interior, Bureau of Land Management or by a decree of a Court of Law and/or that the corner points mentioned in lines 3, 4 and 5 above were in conformance with the rules of the Michigan Board of Land Surveyors or by a Decree of a Court of Law; established, re-established, monumented, re-monumented, recovered, found as expressed below:

NOTE: Not more than 4 corners, all in the same town and range, may be recorded on this certificate.

A. Description of original monument and accessories and/or subsequent restoration:

B-3
GLO Notes
Resurvey 1856
Y. Pine 22" South 37
Maple 8" N20° W 31
George H. Cannon

B. Description of corner evidence found and/or method applied in restoring or reestablishing corner:

B-3
May 8, 1995
Presque Isle County
State Remonumentation
Norman J. Quaine #33984
Porter's Survey P.C.

Fd. no evidence of corner's position
Set 1/2" Rod & Cap #33984
By single Proportion

C. Description of monument for corner and accessories established to perpetuate locating the position of the corner:

B-3
Left 1/2" Rod & Cap #33984
N45° E 7.96' 9" R. Pine
N24° W 16.99' 7" R. Pine
N63° W 8.67' 5" R. Pine
S13° E 24.32' 24" R. Pine

*Witness tags & nails used.

Ratified by Peer Group
in accordance with P.A. 345
Chairman Delmer E. Porter
Date 9/20/95

Signed by Norman J Quaine Date OCTOBER 19, 1995

Surveyor's Michigan License No. 33984

FORM APPROVED BY MICHIGAN STATE BOARD OF LAND SURVEYORS, JAN. 26, 1971
REVISED MAY 14, 1975
REVISED JAN., 1983