

LAND CORNER RECORDATION CERTIFICATE
Filing Requirement of Act 74, Mich. P.A. 1970

94 SEP -6 AM 10:10

For corners in

Presque Isle Located In: Corner Code #
(County)

1. Public Land Survey T36N R 2E B-9
T R
T R
T R

2. Property Controlling S T R
in Section S T R
3. Miscellaneous S T R
Property in Sec. S T R

Janet M. Lamb
REGISTER OF DEEDS

LIBER 311 PAGE 114

Register of Deeds Stamp & File Number

4. Lot No. _____, Recorded Plat _____ SECTION _____
5. Private Claims _____

	A	B	C	D	E	F	G	H	I	J	K	L	M
2	6	5	4	3	2	1							
3													
4	7	8	9	10	11	12							
5													
6	18	17	16	15	14	13							
7													
8	19	20	21	22	23	24							
9													
10	30	29	28	27	26	25							
11													
12	31	32	33	34	35	36							
13													

I, Norman J. Quaine in a field survey on March 7, 1994, do hereby certify that under requirements of P.A. 74, Michigan P.A. of 1970, the corner points mentioned in lines 1 and 2 above were in conformance with regulations and rules therefore as required in the current manual of survey instructions of the United States Department of the Interior, Bureau of Land Management or by a decree of a Court of Law and/or that the corner points mentioned in lines 3, 4 and 5 above were in conformance with the rules of the Michigan Board of Land Surveyors or by a Decree of a Court of Law; established, re-established, monumented, re-monumented, recovered, found as expressed below:

NOTE: Not more than 4 corners, all in the same town and range, may be recorded on this certificate.

A. Description of original monument and accessories and/or subsequent restoration:


B-9
GLO Notes Y. Pine 20" N40° E 26 Lks. 11-2-78 Fd. Old Post & 1" Pipe
Resurvey 1856 Y. Pine 22" S45° W 34 Lks. P. I. County Set by Fredrick Loud,
1936 Set Post & 1" Pipe Local Remon. 1936
Fredrick Loud No witnesses given Project Set 4" Conc. Mon. w/
County Surveyor Loud set by chaining L.C.R.C., brass cap lettered
recorded GLO distance East Page #360 "P.I. Co. Remon."
from Northwest cor. of Sec. Delmer E. S41° W 48.90' 6" Maple
30, with no closing cor. East Porter, LS S12° W 31.78' 10" Mapl
#15410 S18° E 51.14' 5" Maple

B. Description of corner evidence found and/or method applied in restoring or reestablishing corner:

B-9
3-7-94 Found Conc. Mon. & P. I. Co.
P. I. County Remon. Brass cap in Mon. Box
State Remon. S12° W 32.11' 14" Oak
Norman J. Quaine S36° W 48.86' 10" Oak
#33984, Porter's
Survey P.C.

C. Description of monument for corner and accessories established to perpetuate locating the position of the corner:

B-9
Conc. Mon. & P. I. Co.
Remon. Brass Cap in Mon. Box
S12° W 32.11' 14" Oak
S36° W 48.86' 10" Oak
S71° W 67.88' 7" Jack Pine
N43° W 66.50' 8" Aspen

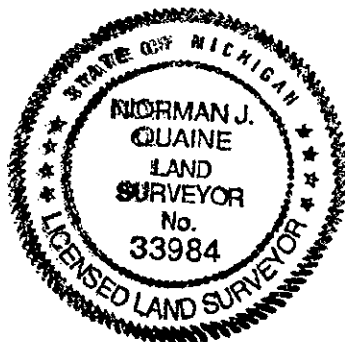

Ratified by Peer Group
in accordance with P.A. 345
Chairman *Delmer E. Porter*
Date August 29, 1994

Signed by *Norman J. Quaine*

Date August 29, 1994

Surveyor's Michigan License No. 33984