

1995 STATE OF MICHIGAN REMONUMENTATION

RECORDED  
95 DEC 11 AM 10:28

2643

COMMISSION

LAND CORNER RECORDATION CERTIFICATE  
Filing Requirement of Act 74, Mich. P.A. 1970

For corners in

Presque Isle Located In: (County)

Corner Code #

- 1. Public Land Survey T 36N R 2E D5
- T \_\_\_\_\_ R \_\_\_\_\_
- T \_\_\_\_\_ R \_\_\_\_\_
- T \_\_\_\_\_ R \_\_\_\_\_
- 2. Property Controlling S \_\_\_\_\_ T \_\_\_\_\_ R \_\_\_\_\_
- in Section S \_\_\_\_\_ T \_\_\_\_\_ R \_\_\_\_\_
- 3. Miscellaneous S \_\_\_\_\_ T \_\_\_\_\_ R \_\_\_\_\_
- Property in Sec. S \_\_\_\_\_ T \_\_\_\_\_ R \_\_\_\_\_

*Janet M. Lamb*  
REGISTER OF DEEDS

LIBER 316 PAGE 930

Register of Deeds Stamp & File Number

- 4. Lot No. \_\_\_\_\_, Recorded Plat \_\_\_\_\_
- 5. Private Claims \_\_\_\_\_

I, James A. Beck in a field survey on May 17, 1995, do hereby certify that under requirements of P.A. 74, Michigan P.A. of 1970, the corner points mentioned in lines 1 and 2 above were in conformance with regulations and rules therefore as required in the current manual of survey instructions of the United States Department of the Interior, Bureau of Land Management or by a decree of a Court of Law and/or that the corner points mentioned in lines 3, 4 and 5 above were in conformance with the rules of the Michigan Board of Land Surveyors or by a Decree of a Court of Law; established, re-established, monumented, re-monumented, recovered, found as expressed below:

NOTE: Not more than 4 corners, all in the same town and range, may be recorded on this certificate.

A	B	C	D	E	F	G	H	I	J	K	L
2	6	5	4	3	2	1					
3											
4	7	8	9	10	11	12					
5		⊙									
6	18	17	16	15	14	13					
7											
8	19	20	21	22	23	24					
9											
10	30	29	28	27	26	25					
11											
12	31	32	33	34	35	36					
13											

A. Description of original monument and accessories and/or subsequent restoration:

D5 1856: Government Resurvey  
\* by Geo. H. Cannon  
Set post and referenced:  
Yellow Pine 14" N34°W 43 Links  
Yellow Pine 14" S56°W 28 Links

Nov. 29, 1978:  
Corner recorded by  
Delmer E. Porter,  
P.S. 15410.  
Found 3" pipe at the intersection of two sand trails. Set conc. monument and brass cap. Referenced:  
N38°W 27.00 9" N. Pine  
S38°W 25.50 8" N. Pine  
S45°E 23.42 6" N. Pine


B. Description of corner evidence found and/or method applied in restoring or reestablishing corner:

D5 May 17, 1995:  
Remonumentation by  
James A. Beck,  
P.S. 21559.

Found conc. monument and brass cap in intersection of two-rut roads running East-West and North-South. Set 1/4" iron rod alongside found monument as monument is non ferro magnetic

Found all witnesses from last record

N38°W 27.00 9" N. Pine  
S38°W 25.50 8" N. Pine  
S45°E 23.42 6" N. Pine

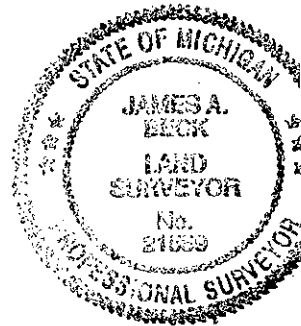

C. Description of monument for corner and accessories established to perpetuate locating the position of the corner:

D5 Concrete monument with brass cap

Referenced:  
old: N38°W 27.07 14" N. Pine  
old: S38°W 25.43 12" N. Pine  
old: S45°E 23.24 10" N. Pine  
new: N15°W 30.94 4" Oak  
new: S47°W 27.94 2" W. Pine  
new: N43°E 62.72 4" Oak

Ratified by Peer Group  
in accordance with P.A. 345  
Chairman: *Delmer E. Porter*  
Date: 11/21/95

witnesses are to new tags P.S. 21559

Signed by James A. Beck  
Surveyor's Michigan License No. 21559

Date 11-28-1995