

**REMONUMENTATION**

**LAND CORNER RECORDATION CERTIFICATE**  
 Filing Requirement of Act 74, Mich. P.A. 1970

94 SEP -6 AM 10:11

For corners in APR 25 1995

*Jane M. Lamb*  
 REGISTER OF DEEDS

Presque Isle County Located In: Corner Code #

|                                       |                          |            |
|---------------------------------------|--------------------------|------------|
| 1. Public Land Survey                 | T <u>36N</u> R <u>2E</u> | <u>D-7</u> |
|                                       | T _____ R _____          | _____      |
|                                       | T _____ R _____          | _____      |
|                                       | T _____ R _____          | _____      |
| 2. Property Controlling In Section    | S _____ T _____ R _____  | _____      |
|                                       | S _____ T _____ R _____  | _____      |
| 3. Miscellaneous Property in Sec.     | S _____ T _____ R _____  | _____      |
|                                       | S _____ T _____ R _____  | _____      |
| 4. Lot No. _____, Recorded Plat _____ |                          |            |
| 5. Private Claims _____               |                          |            |

LIBER 311 PAGE 125

Register of Deeds Stamp & File Number

I, Norman J. Quaine in a field survey on April 11, 1994, do hereby certify that under requirements of P.A. 74, Michigan P.A. of 1970, the corner points mentioned in lines 1 and 2 above were in conformance with regulations and rules therefore as required in the current manual of survey instructions of the United States Department of the Interior, Bureau of Land Management or by a decree of a Court of Law and/or that the corner points mentioned in lines 3, 4 and 5 above were in conformance with the rules of the Michigan Board of Land Surveyors or by a Decree of a Court of Law; established, re-established, monumented, re-monumented, recovered, found as expressed below:

|    | A  | B  | C  | D  | E  | F  | G | H | I | J | K | L | M |
|----|----|----|----|----|----|----|---|---|---|---|---|---|---|
| 2  | 6  | 5  | 4  | 3  | 2  | 1  |   |   |   |   |   |   |   |
| 3  |    |    |    |    |    |    |   |   |   |   |   |   |   |
| 4  | 7  | 8  | 9  | 10 | 11 | 12 |   |   |   |   |   |   |   |
| 5  |    |    |    |    |    |    |   |   |   |   |   |   |   |
| 6  | 13 | 17 | 16 | 15 | 14 | 13 |   |   |   |   |   |   |   |
| 7  |    |    |    |    |    |    |   |   |   |   |   |   |   |
| 8  | 19 | 20 | 21 | 22 | 23 | 24 |   |   |   |   |   |   |   |
| 9  |    |    |    |    |    |    |   |   |   |   |   |   |   |
| 10 | 30 | 29 | 28 | 27 | 26 | 25 |   |   |   |   |   |   |   |
| 11 |    |    |    |    |    |    |   |   |   |   |   |   |   |
| 12 | 31 | 32 | 33 | 34 | 35 | 36 |   |   |   |   |   |   |   |
| 13 |    |    |    |    |    |    |   |   |   |   |   |   |   |

**NOTE: Not more than 4 corners, all in the same town and range, may be recorded on this certificate.**

A. Description of original monument and accessories and/or subsequent restoration:  
 D-7  
 GLO Notes Y. Pine 18" N54°W 122 Lks.  
 Resurvey 1856 Sr. Pine 7" S07°E 26 Lks.

Research to date shows no activity.


B. Description of corner evidence found and/or method applied in restoring or reestablishing corner:  
 D-7  
 4-11-94 Found no evidence  
 Presque Isle County indicating corner's position  
 State Remonumentation Set 1/2" Rod & Cap #15410  
 Norman J. Quaine by single proportion  
 #33984, Porter's  
 Survey, P.C.

C. Description of monument for corner and accessories established to perpetuate locating the position of the corner:  
 D-7  
 1/2" Rod & Cap #15410  
 N56°E 15.41' 9" Red Pine  
 S31°E 36.18' 11" Oak  
 S51°W 36.13' 10" Red Pine  
 N51°W 35.72' 11" Twin Oak

Ratified by Peer Group  
 in accordance with P.A. 345  
 Chairman *Delmer E. Porter*  
 Date July 27, 1994

Signed by Norman J. Quaine  
 Surveyor's Michigan License No. 33984

Date Aug. 17, 1994

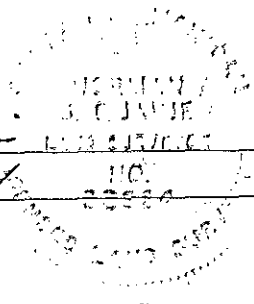

2396