

SURVEY & MONUMENTATION
1995 STATE OF MICHIGAN REMONUMENTATION
 JAN 17 1996

PRESQUE ISLE COUNTY
 RECORDED
 95 DEC 14 AM 10:29

2646

COMMISSION LAND CORNER RECORDATION CERTIFICATE
 Filing Requirement of Act 74, Mich. P.A. 1970

For corners in

Presque Isle Located In: _____ Corner Code #
(County)

1. Public Land Survey T 36N R 2E E3
 T _____ R _____
 T _____ R _____
 T _____ R _____

2. Property Controlling S _____ T _____ R _____
 in Section S _____ T _____ R _____

3. Miscellaneous S _____ T _____ R _____
 Property in Sec. S _____ T _____ R _____

Janet M. Lamb
 REGISTER OF DEEDS

LIBER **316** PAGE **933**

Register of Deeds Stamp & File Number

4. Lot No. _____, Recorded Plat _____
 5. Private Claims _____

A	B	C	D	E	F	G	H	I	J	K	L	M
2	6	5	4	3	2	1						
3			⊕									
4	7	8	9	10	11	12						
5												
6	18	17	16	15	14	13						
7												
8	19	20	21	22	23	24						
9												
10	30	29	28	27	26	25						
11												
12	31	32	33	34	35	36						
13												

I, James A. Beck, in a field survey on Aug 24, 1995, do hereby certify that under requirements of P.A. 74, Michigan P.A. of 1970, the corner points mentioned in lines 1 and 2 above were in conformance with regulations and rules therefore as required in the current manual of survey instructions of the United States Department of the Interior, Bureau of Land Management or by a decree of a Court of Law and/or that the corner points mentioned in lines 3, 4 and 5 above were in conformance with the rules of the Michigan Board of Land Surveyors or by a Decree of a Court of Law; established, re-established, monumented, re-monumented, recovered, found as expressed below:

NOTE: Not more than 4 corners, all in the same town and range, may be recorded on this certificate.

A. Description of original monument and accessories and/or subsequent restoration:

E3 1856: Government Resurvey Set post and referenced:
 * by Geo. H. Cannon Tamarack 11" N40°W 26 Links
 Tamarack 11" S50°E 26 1/2 Links

April, 1968: Corner referred to as "steel stake."
 Corner referenced in South line of section painted.
 ABT Company memo by
 Lyle W. Barden.


B. Description of corner evidence found and/or method applied in restoring or reestablishing corner:

E3 August 24, 1995 Found 1-1/2" pipe projecting 2' in inundated area
 Remonumentation by set P.S. 21559 cap in pipe
 James A. Beck P.S. 21559

Ratified by Peer Group
 in accordance with P.A. 345
 Chairman *[Signature]*
 Date 11/21/95

C. Description of monument for corner and accessories established to perpetuate locating the position of the corner:

E3 1-1/2" pipe projecting 2' in inundated area
 set P.S. 21559 cap in pipe
 Witnesses:
 N 10°E 5.44', 6" Maple
 S 5°W 30.68', 14" Cedar
 S 27°W 12.82', 6" White Birch
 N 30°W 13.11', 4" Black Ash

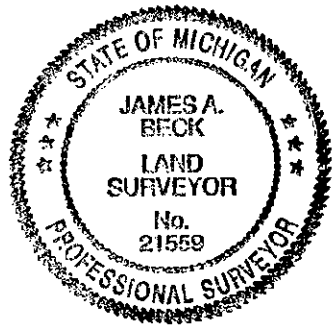

P.S. 21559 Witness tags set in trees

Signed by *James A. Beck* Date 11-28-1995
 Surveyor's Michigan License No. 21559