

# 1995 STATE OF MICHIGAN REMONUMENTATION

PRESQUE ISLE COUNTY  
RECORDED

2647 JAN 17 1996 LAND CORNER RECORDATION CERTIFICATE  
Filing Requirement of Act 74, Mich. P.A. 1970 95 DEC 14 AM 10:29

For corners in **COMMISSION**  
Presque Isle (County)

1. Public Land Survey	T	36N	2E	E4
	T			
	T			
	T			
2. Property Controlling in Section	S			
	S			
3. Miscellaneous Property in Sec.	S			
	S			

*Janet M. Lamb*  
REGISTER OF DEEDS

LIBER **316** PAGE **934**

Register of Deeds Stamp & File Number

4. Lot No. \_\_\_\_\_, Recorded Plat \_\_\_\_\_  
5. Private Claims \_\_\_\_\_

I, James A. Beck, in a field survey on Aug 24, 1995, do hereby certify that under requirements of P.A. 74, Michigan P.A. of 1970, the corner points mentioned in lines 1 and 2 above were in conformance with regulations and rules therefore as required in the current manual of survey instructions of the United States Department of the Interior, Bureau of Land Management or by a decree of a Court of Law and/or that the corner points mentioned in lines 3, 4 and 5 above were in conformance with the rules of the Michigan Board of Land Surveyors or by a Decree of a Court of Law; established, re-established, monumented, re-monumented, recovered, found as expressed below:

A	B	C	D	E	F	G	H	I	J	K	L	M
2	6	5	4	3	2	1						
3												
4	7	8	9	10	11	12						
5												
6	18	17	16	15	14	13						
7												
8	19	20	21	22	23	24						
9												
10	30	29	28	27	26	25						
11												
12	31	32	33	34	35	36						
13												

**NOTE: Not more than 4 corners, all in the same town and range, may be recorded on this certificate.**

A. Description of original monument and accessories and/or subsequent restoration:

1856: **Set post and referenced:**  
Government Resurvey Tamarack 7" N56°E 43 Links  
\*by Geo. H. Cannon Tamarack 8" S40°E 89 Links


B. Description of corner evidence found and/or method applied in restoring or reestablishing corner:

E4 August 24, 1995 Remonumentation by James A. Beck P.S. 21559  
No evidence of original corner or accessories found; set 1/2" iron with P.S. 21559 cap by single proportionate methods using found corner of record at corner of 8, 9, 16 and 17 (E5), and corner common to Sections 4, 5, 8, and 9 (E3) found.

C. Description of monument for corner and accessories established to perpetuate locating the position of the corner:

E4 set 1/2" iron with P.S. 21559 cap  
Witnesses:  
N 34°E 16.41', 5" W. Pine  
N 78°E 10.86', 6" W. Pine  
S 32°E 10.32', 12" Norway Pine  
S 84°W 32.77', 3" Maple  
P.S. 21559 tags set in witness trees

Ratified by Peer Group in accordance with P.A. 345  
Chairman *[Signature]*  
Date 11/21/95

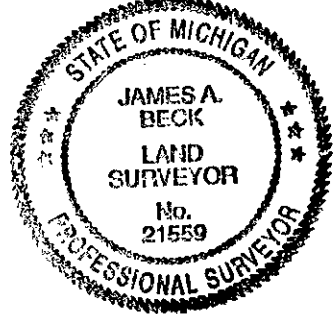

Signed by *James A. Beck* Date 11-28-1995  
Surveyor's Michigan License No. 21559