

1995 STATE OF MICHIGAN REMONUMENTATION

PRESQUE ISLE COUNTY
RECORDED

2648

COMMISSION

LAND CORNER RECORDATION CERTIFICATE 95 DEC 14 AM 10:29
Filing Requirement of Act 74, Mich. P.A. 1970

For corners in

Presque Isle Located In: Corner Code #
(County)

1. Public Land Survey T 36N R 2E E5
T _____ R _____
T _____ R _____
T _____ R _____
T _____ R _____

2. Property Controlling S _____ T _____ R _____
in Section S _____ T _____ R _____

3. Miscellaneous S _____ T _____ R _____
Property in Sec. S _____ T _____ R _____

Jane M. Lamb
REGISTER OF DEEDS

LIBER 316 PAGE 935

Register of Deeds Stamp & File Number

4. Lot No. _____, Recorded Plat _____
5. Private Claims _____

I, James A. Beck, in a field survey on Jul 26, 1995, do hereby certify that under requirements of P.A. 74, Michigan P.A. of 1970, the corner points mentioned in lines 1 and 2 above were in conformance with regulations and rules therefore as required in the current manual of survey instructions of the United States Department of the Interior, Bureau of Land Management or by a decree of a Court of Law and/or that the corner points mentioned in lines 3, 4 and 5 above were in conformance with the rules of the Michigan Board of Land Surveyors or by a Decree of a Court of Law; established, re-established, monumented, re-monumented, recovered, found as expressed below:

A	B	C	D	E	F	G	H	I	J	K	L	M
2	6	5	4	3	2	1						
3												
4	7	8	9	10	11	12						
5			⊙									
6	18	17	16	15	14	13						
7												
8	19	20	21	22	23	24						
9												
10	30	29	28	27	26	25						
11												
12	31	32	33	34	35	36						
13												

NOTE: Not more than 4 corners, all in the same town and range, may be recorded on this certificate.

A. Description of original monument and accessories and/or subsequent restoration:

E5 1856: Government Resurvey By; Geo. H. Cannon Set post and referenced: White Pine 13" N82°W 45 Links White Pine 14" N65°E 74 Links	Sept. 22, 1976: Corner recorded by Ronald Bischer, P.S. 22428.	Found 1/2" rod. Referenced: N04°W 36.45 13" White Pine S72°W 37.07 32" White Pine
	Nov. 29, 1978: Corner recorded by Delmer E. Porter, P.S. 15410.	Found 1/2" rod from previous Porter survey. Set conc. monument and brass cap. Referenced: N04°W 35.45 13" White Pine S72°W 37.07 32" White Pine

B. Description of corner evidence found and/or method applied in restoring or reestablishing corner:

E5 July 26, 1995
Remonumentation by
James A. Beck P.S. 21559


found Presque Isle County Local Remonumentation monument, cement with brass cap and both witness trees from last record
Witness tags grown over, set new P.S. 21559 tags in trees:
Corner falls in low area at extension of fire lane to West and at Wly margin of marsh

Ratified by Peer Group
in accordance with P.A. 74
Commander *[Signature]*
Date 11/21/95

C. Description of monument for corner and accessories established to perpetuate locating the position of the corner:

E5 Presque Isle County Local Remonumentation monument, cement with brass cap

Witnesses:
N 04°W 36.30', 17" W. Pine
S 72°W 37.00', 35" W. Pine
N 58°E 22.17', 10" W. Pine
S 10°E 25.57', 4" W. Pine

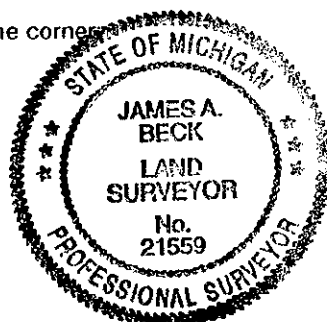


Signed by *James A. Beck* Date 11-28-1995
Surveyor's Michigan License No. 21559