

1995 STATE OF MICHIGAN REMONUMENTATION PRESQUE ISLE COUNTY RECORDED

JAN 17 1996

COMMISSION LAND CORNER RECORDATION CERTIFICATE Filing Requirement of Act 74, Mich. P.A. 1970

95 DEC 14 AM 10: 29

For corners in

Presque Isle Located In: Corner Code # F5

- 1. Public Land Survey T 36N R 2E
2. Property Controlling in Section S T R
3. Miscellaneous Property in Sec. S T R

Jan M. Lamb REGISTER OF DEEDS

LIBER 316 PAGE 938

Register of Deeds Stamp & File Number

- 4. Lot No. Recorded Plat
5. Private Claims

Grid table with columns A-M and rows 2-13. A circled 'X' is located at row 5, column F.

I, James A. Beck in a field survey on Nov 10, 1995, do hereby certify that under requirements of P.A. 74, Michigan P.A. of 1970, the corner points mentioned in lines 1 and 2 above were in conformance with regulations and rules therefore as required in the current manual of survey instructions of the United States Department of the Interior, Bureau of Land Management or by a decree of a Court of Law and/or that the corner points mentioned in lines 3, 4 and 5 above were in conformance with the rules of the Michigan Board of Land Surveyors or by a Decree of a Court of Law; established, re-established, monumented, re-monumented, recovered, found as expressed below:

NOTE: Not more than 4 corners, all in the same town and range, may be recorded on this certificate.

A. Description of original monument and accessories and/or subsequent restoration:

F5 1856: Government Resurvey Sept. 22, 1976: Corner recorded by Ronald Bischer, P.S. 22428. Found 1 1/2" pipe. Referenced: N59°W 5.55 20" Aspen S82°W 24.37 16" Maple N13°E 32.98 10" Birch

B. Description of corner evidence found and/or method applied in restoring or reestablishing corner:


F5 November 10, 1995 Remonumentation by James A. Beck P.S. 21559 found 1-1/2" pipe and 1 witness from last recordation S 82°W 24.37', 16" Maple

Ratified by Peer Group in accordance with P.A. 345 Chairman [Signature] Date 11/21/95

C. Description of monument for corner and accessories established to perpetuate locating the position of the corner:

F5 set 21559 cap in 1-1/2" pipe found Witnesses: S 82°W 24.37', 16" Maple N 28°E 29.55', 6" Ash N 82°E 34.64', 7" Ash S 32°W 60.04', 8 Cedar

set P.S. 21559 witness tags in trees

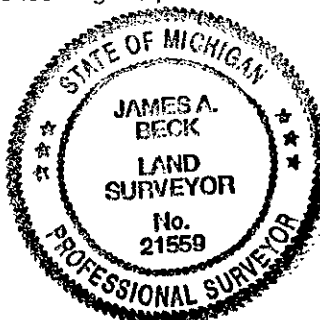

Signed by James A Beck Surveyor's Michigan License No. 21559 Date 11-29-1995