

State of Michigan Remonumentation Program  
For Presque Isle County:

LIBER

310 PAGE 926

PRESQUE ISLE COUNTY  
RECORDED

94 AUG 23 AM 10:10

LAND CORNER RECORDATION CERTIFICATE  
Filing Requirement of Act 74, Mich. P.A. 1970

For corners in

PRESQUE ISLE  
(County)

Located In:

Corner Code ##

- |                                       |                          |            |
|---------------------------------------|--------------------------|------------|
| 1. Public Land Survey                 | T <u>36N</u> R <u>2E</u> | <u>F-9</u> |
|                                       | T _____ R _____          | _____      |
|                                       | T _____ R _____          | _____      |
|                                       | T _____ R _____          | _____      |
| 2. Property Controlling<br>in Section | S _____ T _____ R _____  | _____      |
|                                       | S _____ T _____ R _____  | _____      |
| 3. Miscellaneous<br>Property in Sec.  | S _____ T _____ R _____  | _____      |
|                                       | S _____ T _____ R _____  | _____      |

*Janet M. Lamb*  
REGISTER OF DEEDS

Register of Deeds Stamp & File Number

4. Lot No. \_\_\_\_\_, Recorded Plat \_\_\_\_\_  
5. Private Claims \_\_\_\_\_

	A	B	C	D	E	F	G	H	I	J	K	L	M
2	6	5	4	3	2	1							
3													
4	7	8	9	10	11	12							
5													
6	18	17	16	15	14	13							
7													
8	19	20	21	22	23	24							
9													
10	30	29	28	27	26	25							
11													
12	31	32	33	34	35	36							
13													

I, Ronald Bischer, in a field survey on May 4, 19 94, do hereby certify that under requirements of P.A. 74, Michigan P.A. of 1970, the corner points mentioned in lines 1 and 2 above were in conformance with regulations and rules therefore as required in the current manual of survey instructions of the United States Department of the Interior, Bureau of Land Management or by a decree of a Court of Law and/or that the corner points mentioned in lines 3, 4 and 5 above were in conformance with the rules of the Michigan Board of Land Surveyors or by a Decree of a Court of Law; established, re-established, monumented, re-monumented, recovered, found as expressed below:


**NOTE: Not more than 4 corners, all in the same town and range, may be recorded on this certificate.**

A. Description of original monument and accessories and/or subsequent restoration:

1856 Resurvey - GLO Notes Set Wood Post Beech 8" N25°W 18 links Beech 9" S17°E 29 links	11-06-78 - Delmar E. Porter Found 3" pipe, replaced pipe with 4" concrete monument lettered "Presque Isle County Remonumentation." N20°W 23.55' 9" Twin Maple S55°W 22.31' 14" Oak S40°E 38.29' 18" Oak
9-22-75 - Delmar E. Porter found 3" pipe N38°W 15.84' 6" Maple S11°E 28.46' 6" Maple S55°W 22.31' 14" Oak	

B. Description of corner evidence found and/or method applied in restoring or reestablishing corner:

Found Presque Isle County Remonumentation monument.  
N22°W 38.29' 24" Oak  
S55°W 22.31' 18" Oak  
S40°E 23.40' 9" Maple  
S11°E 28.46' 6" Maple  
stump remains intact  
N38°W 15.84' 6" Maple  
stump remains intact

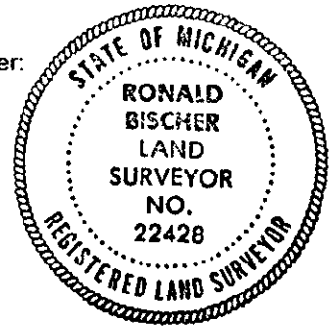

SURVEY &  
REMONUMENTATION

SEP 09 1994

COMMISSION

C. Description of monument for corner and accessories established to perpetuate locating the position of the corner:

Presque Isle County Remonumentation Monument  
N22°W 38.29' 24" Oak  
S55°W 22.31' 18" Oak  
S40°E 23.40' 9" Maple  
N59°E 25.43' 6" Maple

Witness tags w/nails used.

Ratified by Peer Group  
in accordance with P.A. 345

Chairman Delmar E. Porter

Date July 29, 1994

Signed by Ronald R. Bischer

Date July 20, 1994

Surveyor's Michigan License No. 22428