

LAND CORNER RECORDATION CERTIFICATE 94 AUG 23 AM 10:11
Filing Requirement of Act 74, Mich. P.A. 1970

For corners in

<u>PRESQUE ISLE</u> <small>(County)</small>	Located In:	Corner Code #
1. Public Land Survey	T <u>36N</u> R <u>2E</u>	<u>F-11</u>
	T _____ R _____	_____
	T _____ R _____	_____
	T _____ R _____	_____
2. Property Controlling in Section	S _____ T _____ R _____	_____
	S _____ T _____ R _____	_____
3. Miscellaneous Property in Sec.	S _____ T _____ R _____	_____
	S _____ T _____ R _____	_____

Janet M. Lamb
REGISTER OF DEEDS

LIBER **310** PAGE **931**

Register of Deeds Stamp & File Number

4. Lot No. _____, Recorded Plat _____
5. Private Claims _____

I, Ronald Bischer, in a field survey on April 5, 19 94,
do hereby certify that under requirements of P.A. 74, Michigan P.A. of 1970, the corner points mentioned
in lines 1 and 2 above were in conformance with regulations and rules therefore as required in the
current manual of survey instructions of the United States Department of the Interior, Bureau of Land
Management or by a decree of a Court of Law and/or that the corner points mentioned in lines 3, 4 and 5
above were in conformance with the rules of the Michigan Board of Land Surveyors or by a Decree of a
Court of Law; established, re-established, monumented, re-monumented, recovered, found as
expressed below:

**NOTE: Not more than 4 corners, all in the same town and range, may be recorded
on this certificate.**

	A	B	C	D	E	F	G	H	I	J	K	L	M
2	6		5		4		3		2		1		
3													
4	7		8		9		10		11		12		
5													
6	18		17		16		15		14		13		
7													
8	19		20		21		22		23		24		
9													
10	30		29		28		27		26		25		
11													
12	31		32		33		34		35		36		
13													

A. Description of original monument and accessories and/or subsequent restoration:

F-11
GLO Notes, Resurvey 1856
Set Wood Post
Sp. Pine 10" S17°W 137 links
Sp. Pine 10" N40°E 75 links
1971 - Delmar E. Porter
Found 2" Iron pipe
N15°E 19.96' 12" Jack Pine
N70°W 56.56' 14" Jack Pine
S45°W 59.15' 9" Jack Pine
1978 - Delmar E. Porter
Found 2" Pipe, replaced pipe w/
conc. mon. with brass cap
N15°E 19.96' 12" Jack Pine
N70°W 56.56' 14" Jack Pine
S45°W 59.15' 9" Jack Pine
1992 - Norman J. Quaine
Found conc. mon. w/brass cap
North 33.00' concrete monument


B. Description of corner evidence found and/or method applied in restoring or reestablishing corner:

F-11
Found concrete monument w/brass cap lettered "Presque Isle County Remonumentation"
N70°W 56.56' 20" J. Pine
found nail w/tag #15410
N19°E 20.03' 16" J. Pine
found nail w/tag #15410
North 33.03' Concrete monument
S45°W 59.15' 9" J. Pine
witness gone

SURVEY &
REMONUMENTATION

SEP 09 1994

COMMISSION

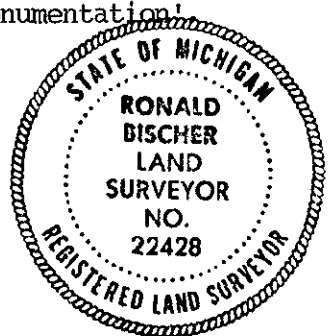

C. Description of monument for corner and accessories established to perpetuate locating the position of the corner:

F-11
Presque Isle County Remonumentation Monument
N70°W 56.56' 20" Jack Pine
N19°E 20.03' 16" Jack Pine
North 33.02' Concrete monument
S42°E 48.91' Power pole

Ratified by Peer Group
in accordance with P.A. 345
Chairman *Delmar E. Porter*
Date July 27, 1994

Set nail w/tag #22428 in power pole.

Signed by Ronald R. Bischer

Date July 20, 1994

Surveyor's Michigan License No. 22428